

15-065-20782-00-00


STATE OF KANSAS  
STATE CORPORATION COMMISSION

Form CP-4

WELL PLUGGING RECORD

Give All Information Completely  
Make Required Affidavit  
Mail or Deliver Report to:  
Conservation Division  
State Corporation Commission

P. O. Box 17027  
Wichita, Kansas 67217  
NORTH

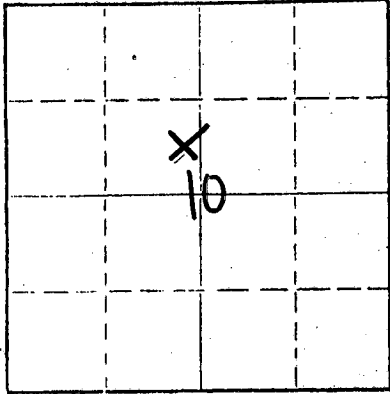

Locate well correctly on above  
Section Plat

Graham County, Sec. 10 Twp. 9S Rge. 21(W)

Location as "NE/CNWxSWx" or footage from lines C E 72 SE NW

Lease Owner Kansas Petroleum, Inc

Lease Name GOSSELIN Well No. #2

Office Address 500 Insurance Bldg. Wichita, Kansas 67202

Character of Well (completed as Oil, Gas or Dry Hole) Dry Hole

Date well completed October 19, 1975

Application for plugging filed (verbally) October 19, 1975

Application for plugging approved (verbally) October 19, 1975

Plugging commenced October 19, 1975

Plugging completed October 19, 1975

Reason for abandonment of well or producing formation No commercial quantity of oil or gas encountered

If a producing well is abandoned, date of last production 19

Was permission obtained from the Conservation Division or its agents before plugging was commenced? Yes

Name of Conservation Agent who supervised plugging of this well Gilbert Balthazor

Producing formation Depth to top Bottom Total Depth of Well 3755 Feet

Show depth and thickness of all water, oil and gas formations.

OIL, GAS OR WATER RECORDS

CASING RECORD

FORMATION	CONTENT	FROM	TO	SIZE	PUT IN	PULLED OUT
				8 5/8"	218'	None

Describe in detail the manner in which the well was plugged, indicating where the mud fluid was placed and the method or methods used in introducing it into the hole. If cement or other plugs were used, state the character of same and depth placed, from feet to feet for each plug set.

1st Plug Set @ 750' with 70 sx cement  
2nd Plug Set @ 200' with 20 sx cement  
3rd Plug Set @ 40' with 10 sx cement  
Plug was down @ 9:00 a.m. 10-19-75

RECEIVED  
STATE CORPORATION COMMISSION

OCT 22 1975

CONSERVATION DIVISION  
Wichita, Kansas

10-22-75

(If additional description is necessary, use BACK of this sheet)  
Name of Plugging Contractor Abercrombie Drilling, Inc.  
Address 801 Union Center, Wichita, Kansas 67202

STATE OF KANSAS, COUNTY OF SEDGWICK, ss.  
Jerry A. Langrehr-Exec. V.P. (employee of owner) or (owner or operator) of the above-described well, being first duly sworn on oath, says: That I have knowledge of the facts, statements, and matters herein contained and the log of the above-described well as filed and that the same are true and correct. So help me God.

(Signature) Jerry A. Langrehr  
801 Union Center, Wichita, Ks (Address)

Subscribed and sworn to before me this 21st day of October, 1975

Sandra Russell  
Sandra Russell Notary Public.



CONTRACTOR'S WELL LOG

15-065-20782-00-00

OPERATOR: Kansas Petroleum, Inc.  
 CONTRACTOR: Abercrombie Drilling, Inc.  
 WELL NAME: GOSSELIN #2  
 LOCATION: C E/2 SE NW Sec. 10-9S-21W  
 Graham County, Kansas  
 GEOLOGIST: Dick Roby  
 SPUD DATE: October 11, 1975  
 COMPLETION DATE: October 19, 1975

0	60	Post Rock
60	170	Clay & Sand
170	727	Shale
727	853	Sand
853	856	Shale
856	1637	Shale & Sand
1637	1674	Anhydrite
1674	2380	Shale
2380	3028	Shale & Lime
3028	3331	Lime & Shale
3331	3755	Lime
	3755	Rotary Total Depth

Spudded in @ 6:30 p.m. October 11, 1975. Cut 225' of 12 1/2" hole. Ran 5 jts. of 8 5/8" casing. Tallied 210'. Set casing @ 218'. Cemented with 150 sx. Sunset Cement. Plug was down @ 10:00 p.m. October 11, 1975. Drilled plug @ 4:00 a.m. October 12, 1975.

Plugged and Abandoned: 1st Plug Set @ 750' with 70 sx. cement; 2nd Plug Set @ 200' with 20 sx. cement; 3rd Plug Set @ 40' with 10 sx. cement. Plug was down 2 9:00 a.m. October 19, 1975. State Plugger: Gilbert Balthazor

SAMPLE TOPS:  
 Anhydrite 1637' (+535)  
 B/Anhydrite 1674' (+498)

RECEIVED  
 STATE CORPORATION COMMISSION

OCT 22 1975

CONSERVATION DIVISION  
 Wichita, Kansas

10-22-75

STATE OF KANSAS )  
 ) SS  
 COUNTY OF SEDGWICK )

Jerry A. Langrehr, Executive Vice President of Abercrombie Drilling, Inc., does hereby state that the above and foregoing is a true and correct copy of the log of the GOSSELIN #2, C E/2 SE NW, Section 10-9S-21W, Graham County, Kansas

ABERCROMBIE DRILLING, INC.

By: Jerry A. Langrehr  
 Jerry A. Langrehr, Exec. V.P.

Subscribed and sworn to before me, a Notary Public, in and for the aforesaid county and state as of this 21st day of October, 1975.

Sandra Russell  
 Sandra Russell-Notary Public



My Commission Expires: July 21, 1979