


15-065-21436-00-00 FORM CP-4

STATE OF KANSAS  
STATE CORPORATION COMMISSION

WELL PLUGGING RECORD

Give All Information Completely  
Make Required Affidavit  
Mail or Deliver Report to  
Conservation Division  
State Corporation Comm.  
245 North Water  
Wichita, KS 67202

Graham County, Sec. 10 Twp. 9S Rge. 21 E/W  
Location as "NE/CNW1SW1" or footage from lines \_\_\_\_\_  
S $\frac{1}{2}$  S $\frac{1}{2}$  NE  
Lease Owner Helberg Oil Company  
Lease Name Desair Well No. 1  
Office Address Box 32 Morland, Kansas 67650  
Character of Well (Completed as Oil, Gas or Dry Hole) \_\_\_\_\_

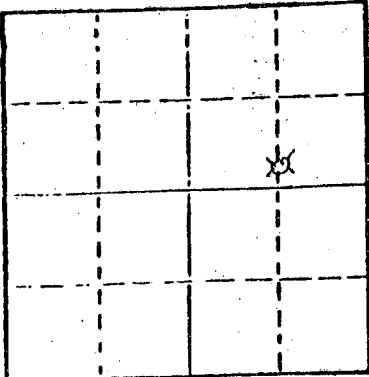

Dry hole  
Date Well completed June 4 19 81  
Application for plugging filed June 4 19 81  
Application for plugging approved June 4 19 81  
Plugging commenced June 4 19 81  
Plugging completed June 4 19 81  
Reason for abandonment of well or producing formation \_\_\_\_\_

Dry hole  
If a producing well is abandoned, date of last production \_\_\_\_\_ 19 \_\_\_\_\_

Was permission obtained from the Conservation Division or its agents before plugging was commenced? Yes

Name of Conservation Agent who supervised plugging of this well Gil Balthazor  
Producing formation \_\_\_\_\_ Depth to top \_\_\_\_\_ Bottom \_\_\_\_\_ Total Depth of Well 3728'  
Show depth and thickness of all water, oil and gas formations.

OIL, GAS OR WATER RECORDS

CASING RECORD

FORMATION	CONTENT	FROM	TO	SIZE	PUT IN	PULLED OUT
Surface		0	218'	8 5/8"	218'	0'

Describe in detail the manner in which the well was plugged, indicating where the mud fluid was placed and the method or methods used in introducing it into the hold. If cement or other plugs were used, state the character of same and depth placed, from \_\_\_\_\_ feet to \_\_\_\_\_ feet for each plug set.

- 1st plug set at 920' with 60 sacks common cement 6% gel 50-50 poz
- 2nd. plug set at 240' with 30 sacks common cement 6% gel 50-50-poz
- 3rd. plug set at 40' with 10 sacks common cement 6% gel 50-50 poz
- 5 sacks cement in rat hole

(If additional description is necessary, use BACK of this sheet)

Name of Plugging Contractor Sun Oilwell Cementing

STATE OF Kansas COUNTY OF Graham, ss.  
Jerry M. Helberg (owner or operator)


of the above-described well, being first duly sworn on oath, says: That I have knowledge of the facts, statements, and matters herein contained and the log of the above-described well as filed and that the same are true and correct. So help me God.

(Signature) Jerry M. Helberg  
Box 32 Morland, Kansas 67650  
(Address)

SUBSCRIBED AND SWORN TO before me this 16 day of June, 19 81

Janice Robinson  
Notary Public.

My commission expires 12-4-83

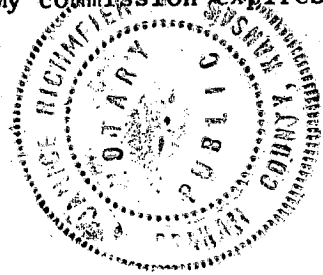

6-17-81

15-065-21436-00-00

DRILLERS LOG

DESAIR #1

CASING RECORD:

8 5/8" set at 218'

TOTAL DEPTH:

3728'

OPERATOR: Helberg Oil Company

CONTRACTOR: Helberg Oil Company

COMMENCED: May 27, 1981

COMPLETED: June 4, 1981

DESCRIPTION:

S $\frac{1}{2}$  S $\frac{1}{2}$  NE  
Section 10 Township 9S Range 21W

FORMATION	FROM	TO	REMARKS
Shale and Sand	0	228	
Shale and Sand	228	860	
Sand and Shale	860	1637	
Shale	1637	1658	
Anhydrite	1658	1694	
Shale	1694	1924	
Shale	1924	2174	
Shale	2174	2360	
Shale	2360	2505	
Shale	2505	2637	
Shale	2637	2780	
Shale and Lime	2780	2905	
Shale and Lime	2905	3032	
Shale and Lime	3032	3141	
Shale and Lime	3141	3287	
Shale and Lime	3287	3382	
Lime	3382	3438	
Lime and Shale	3438	3483	
Lime and Shale	3483	3544	
Lime and Shale	3544	3563	
Lime	3563	3590	
Lime	3590	3654	
Lime and Shale	3654	3721	
Lime	3721	3728	
T.D.	3728		D&A

I certify that the above is a true and correct copy of the log to the best of my knowledge.

Helberg Oil Company

*Jerry M. Helberg*  
Jerry M. Helberg

Subscribed and sworn to before me this 16 day of June, 1981.

*Janice Robinson*  
Notary Public

My commission expires Dec. 4, 1983.

