

15-179-20091-00-00


STATE OF KANSAS
STATE CORPORATION COMMISSION

Form CP-4

Give All Information Completely
Make Required Affidavit
Mail or Deliver Report to:
Conservation Division
State Corporation Commission
212 No. Market
Wichita, Kansas

WELL PLUGGING RECORD

NORTH

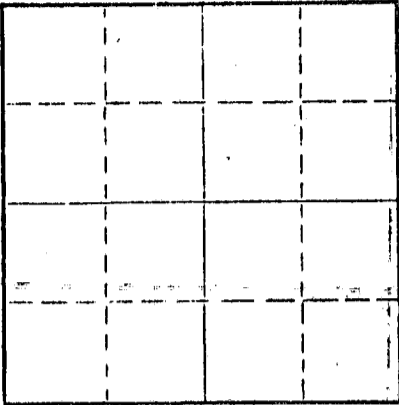

Locate well correctly on above
Section Plat

Sheridan County, Sec. 24 Twp. 8S Rge. (E) 27 (W)

Location as "NE/CNW%SW%" or footage from lines C SE NE
Lease Owner Chief Drilling Co., Inc.

Lease Name TAYLOR Well No.

Office Address Box 797 - Great Bend, Kansas 67530

Character of Well (completed as Oil, Gas or Dry Hole) Dry Hole

Date well completed 10/23/67

Application for plugging filed 10/23/67

Application for plugging approved 10/23/67

Plugging commenced 10/23/67

Plugging completed 10/23/67

Reason for abandonment of well or producing formation Dry Hole

If a producing well is abandoned, date of last production 19

Was permission obtained from the Conservation Division or its agents before plugging was commenced? Yes

Name of Conservation Agent who supervised plugging of this well W.L. Nichelson - Morland, Kansas

Producing formation Depth to top Bottom Total Depth of Well 3980 Feet

Show depth and thickness of all water, oil and gas formations.

OIL, GAS OR WATER RECORDS

CASING RECORD

FORMATION	CONTENT	FROM	TO	SIZE	PUT IN	PULLED OUT
		0	201	8-5/8"	201	None

Describe in detail the manner in which the well was plugged, indicating where the mud fluid was placed and the method or methods used in introducing it into the hole. If cement or other plugs were used, state the character of same and depth placed, from feet to feet for each plug set.

100 sacks cement at 1050'
Wooden plug @ 210'
Mixed 20 sacks cement through drill pipe
Wooden plug set @ 40'
Mixed 10 sacks cement through drill pipe
4 sacks cement in rat hole

RECEIVED
STATE CORPORATION COMMISSION
OCT 25 1967

CONSERVATION DIVISION
WICHITA, KANSAS
10-25-67

(If additional description is necessary, use BACK of this sheet)

Name of Plugging Contractor Chief Drilling Co., Inc.
Address Box 797 - Great Bend, Kansas 67530

STATE OF KANSAS, COUNTY OF BARTON, ss.
Jim Robinson (employee of owner) or (owner or operator) of the above-described well, being first duly sworn on oath, says: That I have knowledge of the facts, statements, and matters herein contained and the log of the above-described well as filed and that the same are true and correct. So help me God.

(Signature) Jim Robinson
Box 797 - Great Bend, Kansas 67530 (Address)

Subscribed and sworn to before me this 24th day of October, 1967

Carmen R. Cook
Carmen R. Cook, Notary Public.



15-179-20051-00-00

WELL LOG

Chief Drilling Co., Inc.
Box 797
Great Bend, Kansas

TAYLOR #1
C SE NE Sec. 24-8S-27W
Sheridan County, Kansas

Contractor: Chief Drilling Co., Inc.

Commenced: 10-16-67
Completed: 10-23-67

Casing Record: 8-5/8" set @ 201' w/160 sacks Common Sunset Cement.

DRY & ABANDONED

<u>FORMATION</u>	<u>FROM</u>	<u>TO</u>	<u>ELEVATION</u>
			2559 Gr.
Sand & Clay	0	201	2561 D.F.
Shale	201	1060	2564 K.B.
Shale, Shells & Sand	1060	1290	
Sand	1290	1465	
Shale & Sand	1465	2199	
Anhydrite	2199	2236	
Shale & Shells	2236	2665	
Shale & Lime	2665	3734	
Lime	3734	3980	
Total Depth	3980		

<u>FORMATION TOPS</u>	
Anhydrite	2199 + 365
Heebner	3701 -1137
Toronto	3721 -1157
Lansing	3734 -1170
Base Kansas City	3960 -1396
Total Depth	3980 -1416

STATE OF KANSAS, COUNTY OF BARTON) SS

I hereby certify that the above is a true and correct copy of the Driller's Log of the well drilled in the C SE NE Section 24-8S-27W, Sheridan County, Kansas, to the best of my knowledge and belief.

CHIEF DRILLING CO., INC.

Jim Robinson
Jim Robinson, Office Manager

Subscribed and sworn to before me this 24th day of October, 1967.

Carmen R. Cook
Carmen R. Cook, Notary Public

My Commission Expires: Dec. 12, 1970.



RECEIVED
STATE CORPORATION COMMISSION

OCT 25 1967

CONSERVATION DIVISION
Wichita, Kansas