


15-179-20304-00-00

STATE OF KANSAS  
STATE CORPORATION COMMISSION

Form CP-4

Give All Information Completely  
Make Required Affidavit  
Mail or Deliver Report to:  
Conservation Division  
State Corporation Commission  
212 No. Market  
Wichita, Kansas 67202

WELL PLUGGING RECORD

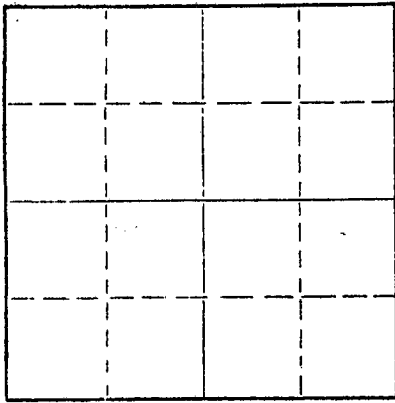

Locate well correctly on above  
Section Plat

Sheridan County, Sec. 24 Twp. 8 Rge. 27 (E) W (W)

Location as "NE/CNW/SW" or footage from lines 440 N. of S.L. 440 E. of 1/2 M.L. SW/SE

Lease Owner Dreiling Oil, Inc.

Lease Name Taylor

Well No. 1

Office Address Victoria, Kansas 67671

Character of Well (completed as Oil, Gas or Dry Hole) Dry Hole

Date well completed 3-28 19 72

Application for plugging filed 3-28 19 72

Application for plugging approved 3-28 19 72

Plugging commenced 3-28 19 72

Plugging completed 3-28 19 72

Reason for abandonment of well or producing formation Dry Hole

If a producing well is abandoned, date of last production \_\_\_\_\_ 19 \_\_\_\_\_

Was permission obtained from the Conservation Division or its agents before plugging was commenced? yes

Name of Conservation Agent who supervised plugging of this well Bill Nichols Morland, Kansas

Producing formation \_\_\_\_\_ Depth to top \_\_\_\_\_ Bottom \_\_\_\_\_ Total Depth of Well \_\_\_\_\_ Feet

Show depth and thickness of all water, oil and gas formations.

OIL, GAS OR WATER RECORDS

CASING RECORD

FORMATION	CONTENT	FROM	TO	SIZE	PUT IN	PULLED OUT
Surface Pipe				8 5/8	196'	

Describe in detail the manner in which the well was plugged, indicating where the mud fluid was placed and the method or methods used in introducing it into the hole. If cement or other plugs were used, state the character of same and depth placed, from \_\_\_\_\_ feet to \_\_\_\_\_ feet for each plug set.

1st plug was set @ 1325' with 110 cu ft. cement

2nd plug was set @ 215' with 30 cu ft. cement

3rd plug was set @ 40' with 10 cu. ft. cement

RECEIVED  
STATE CORPORATION COMMISSION  
APR 3 - 1972  
CONSERVATION DIVISION  
Wichita, Kansas

4-3-72

(If additional description is necessary, use BACK of this sheet)

Name of Plugging Contractor Dreiling Oil, Inc.

Address Victoria, Kansas 67671

STATE OF Kansas, COUNTY OF Ellis, ss.

Im Joe Hess, Sec. Treas. of Drilg. Contrc. (employer of record) of the above-described well, being first duly sworn on oath, says: That I have knowledge of the facts, statements, and matters herein contained and the log of the above-described well as filed and that the same are true and correct. So help me God.

(Signature) \_\_\_\_\_

JOE HESS Route # 2 Victoria, Kansas 67671  
(Address)

Subscribed and sworn to before me this 30 day of March, 19 72

Patty Rohr  
PATTY ROHR

Notary Public.

My commission expires July 20, 1975

