

15-179-20810-00-00

STATE OF KANSAS  
STATE CORPORATION COMMISSION

WELL PLUGGING RECORD

Give All Information Completely  
Make Required Affidavit  
Mail or Deliver Report to  
Conservation Division  
State Corporation Comm.  
245 North Water  
Wichita, KS 67202

Sheridan County, Sec. 24 Twp. 8 S Rge. 27 ~~XX~~/W  
Location as "NE/CNW $\frac{1}{2}$ SW $\frac{1}{2}$ " or footage from lines \_\_\_\_\_  
SW SW SW

Lease Owner Zenith Drilling Corp., Inc.  
Lease Name Taylor Well No. 1

Office Address 200 W. Douglas, Suite 600, Wichita, Ks. 67202  
Character of Well (Completed as Oil, Gas or Dry Hole) \_\_\_\_\_

Dry Hole


Date Well completed June 20 1978  
Application for plugging filed (verbally) June 20 1978  
Application for plugging approved (verbally) June 20 1978  
Plugging commenced June 20 1978  
Plugging completed June 20 1978

Reason for abandonment of well or producing formation \_\_\_\_\_  
No commercial quantity of oil or gas encountered

If a producing well is abandoned, date of last production \_\_\_\_\_  
19 \_\_\_\_\_

Was permission obtained from the Conservation Division or  
its agents before plugging was commenced? Yes

Name of Conservation Agent who supervised plugging of this well Gilbert Balthazor  
Producing formation \_\_\_\_\_ Depth to top \_\_\_\_\_ Bottom \_\_\_\_\_ Total Depth of Well 3950  
Show depth and thickness of all water, oil and gas formations.

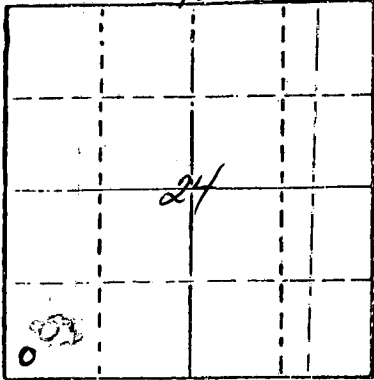

Locate well correctly on above  
Section Plat

OIL, GAS OR WATER RECORDS

CASING RECORD

FORMATION	CONTENT	FROM	TO	SIZE	PUT IN	PULLED OUT

Describe in detail the manner in which the well was plugged, indicating where the mud fluid  
was placed and the method or methods used in introducing it into the hold. If cement or other  
plugs were used, state the character of same and depth placed, from \_\_\_\_\_ feet to  
\_\_\_\_\_ feet for each plug set.

Set 1st plug at 1000' with 70 sacks  
2nd plug at 240' with 20 sacks  
3rd plug at 40' with 10 sacks  
Cemented with 50/50 posmix, 6% gel.

RECEIVED  
STATE CORPORATION COMMISSION

JUN 29 1978

CONSERVATION DIVISION  
Wichita, Kansas

629-78

(If additional description is necessary, use BACK of this sheet)

Name of Plugging Contractor Abercrombie Drilling, Inc.

STATE OF KANSAS COUNTY OF SEDGWICK, ss.

Jack L. Partridge, Ass't. Sec.-Treas. (employee of owner) or (owner or operator)  
of the above-described well, being first duly sworn on oath, says: That I have knowledge of  
the facts, statements, and matters herein contained and the log of the above-described well  
as filed and that the same are true and correct. So help me God.

(Signature)

*Jack L. Partridge*

801 Union Center, Wichita, Kansas 67202  
(Address)

Subscribed and sworn to before me this 28th day of June, 1978

*Sandra Richman*

Sandra Richman Notary Public.



