


WELL PLUGGING RECORD

15-179-20726-0000

Give All Information Completely
 Make Required Affidavit

COUNTY Sheridan SEC. 25 TWP. 8S RGE. 27W E/W
 Location as in quarters or footage from lines:
SW SW SE

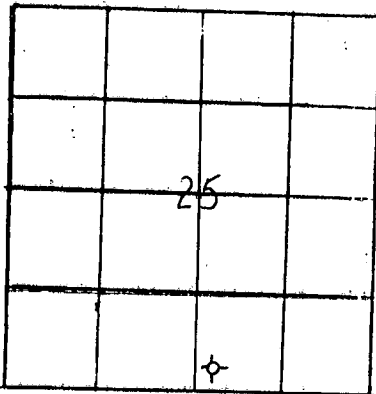

Locate Well
 correctly on above
 Section Platt.

Lease Owner Mid-Continent Energy Corporation
 Lease Name Brown Well No. 1
 Office Address 120 Bldg., Suite 712, Wichita, Ks. 67202
 Character of Well (Completed as Oil, Gas or Dry Hole): dry hole
 Date Well Completed 2-12-84
 Application for plugging filed _____
 Plugging commenced 2-12-84
 Plugging completed 2-12-84
 Reason for abandonment of well or producing formation (CL)
dry hole

Was permission obtained from the Conservation Division or it's
 Agent's before plugging was commenced? Yes

Name of Conservation Agent who supervised plugging of this well Gilbert Scheck
 Producing formation _____ Depth to top _____ bottom T.D. 4023'
 Show depth and thickness of all water, oil and gas formations.

OIL, GAS OR WATER RECORDS

Casing Record

Formation	Content	From	To	Size	Put in	Pulled Out
		0	262'	8 5/8"	262'	-0-

Describe in detail the manner in which the well was plugged, indicating where the mud
 fluid was placed and the method or methods used in introducing it into the hold. If cement
 or other plugs were used, state the character of same and depth placed, from _____ feet
 to _____ feet for each plug set.

Plugged through drill pipe @ 2250' w/20 sx., @
 1400' w/100 sx. (1 sx celloflake), @ 300' w/40 sx.
 bridge @ 40' w/10 sx., 10 sx. in rathole; 50/50 poz,
 6% gel, 2% c.c.

(If additional description is necessary, use BACK of this sheet)

Name of Plugging Contractor B & B Drilling, Inc.


STATE OF KANSAS COUNTY OF SEDGWICK, ss.

(employee of owner) or (owner or operator) of the
 above-described well, being first duly sworn on oath, says: That I have knowledge of the
 facts, statements, and matters herein contained and the log of the above-described well as
 filed and that the same are true and correct. So help me God.

(Signature) [Signature]
 MID-CONTINENT ENERGY CORP.
120 Bldg., Suite 712, Wichita, Ks.
 (Address)

SUBSCRIBED AND SWORN TO before me this 22nd day of February, 1984

My Commission expires: _____

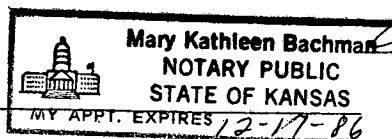

[Signature]
 Notary Public.

RECEIVED
 STATE CORPORATION COMMISSION

FEB 23 1984
 CONSERVATION DIVISION
 Wichita, Kansas