


15-179-20165-00-00

STATE OF KANSAS STATE CORPORATION COMMISSION

Give All Information Completely Make Required Affidavit Mail or Deliver Report to: Conservation Division State Corporation Commission 212 No. Market Wichita, Kansas

WELL PLUGGING RECORD

Sheridan County. Sec. 32 Twp. 8 Rge. 29 (E) W (W) Location as "NE/CNW%SW%" or footage from lines SE NE NW Lease Owner Benjamin B. Tepper Lease Name Koster Well No. 4 Office Address 7751 Carondelet Ave., Hill City, Kansas Character of Well (completed as Oil, Gas or Dry Hole) Dry Hole Date well completed 12-6 19 68 Application for plugging filed 12-6- 1968 Application for plugging approved 12-6-68 Plugging commenced 12-6- 19 68 Plugging completed 12-6- 19 68 Reason for abandonment of well or producing formation Dry

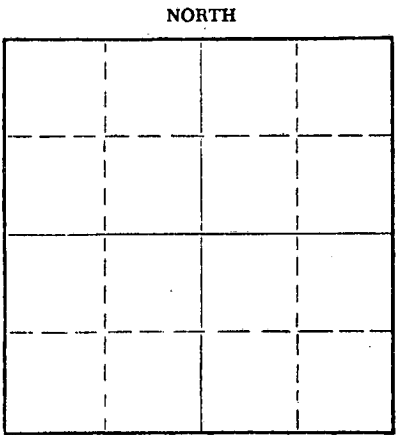

If a producing well is abandoned, date of last production 19 Was permission obtained from the Conservation Division or its agents before plugging was commenced? yes

Name of Conservation Agent who supervised plugging of this well W. L. Nichol Producing formation Depth to top Bottom Total Depth of Well 4141 Feet Show depth and thickness of all water, oil and gas formations.

Table with 7 columns: FORMATION, CONTENT, FROM, TO, SIZE, PUT IN, PULLED OUT. Row 1: 0, 226, 7" XIXX, 216, -0-

Describe in detail the manner in which the well was plugged, indicating where the mud fluid was placed and the method or methods used in introducing it into the hole. If cement or other plugs were used, state the character of same and depth placed, from feet to feet for each plug set.

- # 1 Plug @ 1625' W/65 sacks Cement # 2 Plug @ 245' W/15 sacks cement # 3 Plug @ 40' W/10 sacks cement

RECEIVED STATE CORPORATION COMMISSION DEC 11 1968 CONSERVATION DIVISION Wichita, Kansas


12-11-68

(If additional description is necessary, use BACK of this sheet) Name of Plugging Contractor Halliburton Co Address Hill City, Kansas

STATE OF Kansas, COUNTY OF Graham, ss. Louis Edgett (employee of owner) or (owner or operator) of the above-described well, being first duly sworn on oath, says: That I have knowledge of the facts, statements, and matters herein contained and the log of the above-described well as filed and that the same are true and correct. So help me God.

(Signature) Louis Edgett Louis Edgett, Bookkeeper P. O. Box D, Hill City, Kansas (Address)

SUBSCRIBED AND SWORN to before me this 10th day of December, 1968 My commission expires 20, 1972 Notary Public.

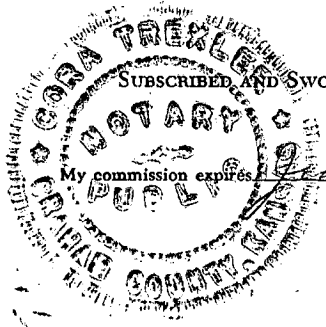

15-179-20165-00-00

CONTRACTOR'S WELL LOG

COMPANY: BENJAMIN B. TEPPER
 CONTRACTOR: PAINE DRILLING CO., INC.
 WELL: KOSTER # 4
 LOCATION: SE NE NW Sec. 32-8S-29W
 SHERIDAN COUNTY, KANSAS
 COMMENCED: NOVEMBER 25, 1968
 COMPLETED: DECEMBER 6, 1968

0	226	Surface Soil & Sand
226	1870	Shale & Sand
1870	2461	Shale
2461	2499	Anhydrite
2499	- 3220	Shale
3220	3961	Lime & Shale
3961	4141	Lime

RECEIVED
 STATE CORPORATION COMMISSION
 DEC 16 1968
 CONSERVATION DIVISION
 Wichita, Kansas
 12-16-68

Set 7" Surface Pipe at 226' W/135 SACKS CEMENT

DRY AND ABANDONED

WE HEREBY CERTIFY THAT THE ABOVE IS A CORRECT AND ACCURATE LOG OF THE ABOVE MENTIONED WELL, AS SHOWN ON THE DAILY DRILLING REPORTS.

PAINE DRILLING CO., INC.

BY: Louis Edgett
 LOUIS EDGETT BOOKKEEPER

SUBSCRIBED AND SWORN TO BEFORE ME THIS 13th DAY OF DECEMBER, 1968



Paul Pfeiffer
 NOTARY PUBLIC

MY COMMISSION EXPIRES June 20, 1972