


15-179-20169-00-00

STATE OF KANSAS  
STATE CORPORATION COMMISSION

WELL PLUGGING RECORD

Give All Information Completely  
Make Required Affidavit  
Mail or Deliver Report to:  
Conservation Division  
State Corporation Commission  
212 No. Market  
Wichita, Kansas

Sheridan County. Sec. 32 Twp. 8S Rge. 29 (E) W (W)  
Location as "NE/CNW&SW&" or footage from lines NW SE NE  
Lease Owner Benjamin E. Tepper  
Lease Name Koster Well No. 5  
Office Address 7751 Carondelet Ave., Clayton, Mo  
Character of Well (completed as Oil, Gas or Dry Hole) Dry Hole  
Date well completed 12-16 19 68  
Application for plugging filed 12-16 19 68  
Application for plugging approved 12-16-19 68  
Plugging commenced 12 16 19 68  
Plugging completed 12-16 19 68  
Reason for abandonment of well or producing formation Dry Hole

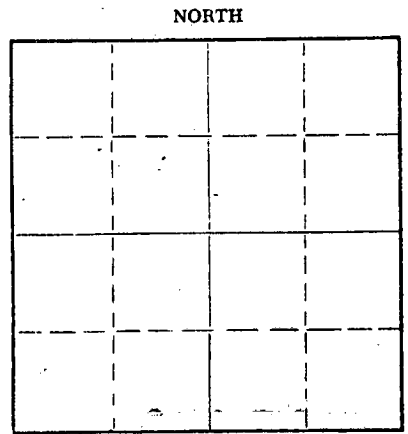

Locate well correctly on above Section Plat

If a producing well is abandoned, date of last production 19  
Was permission obtained from the Conservation Division or its agents before plugging was commenced? yes

Name of Conservation Agent who supervised plugging of this well W. L. Nichol  
Producing formation Depth to top Bottom Total Depth of Well 4190 Feet  
Show depth and thickness of all water, oil and gas formations.

OIL, GAS OR WATER RECORDS

CASING RECORD

FORMATION	CONTENT	FROM	TO	SIZE	PUT IN	PULLED OUT
	RECEIVED STATE CORPORATION COMMISSION DEC 20 1968 CONSERVATION DIVISION Wichita, Kansas		239	7'	229	

12-20-68

Describe in detail the manner in which the well was plugged, indicating where the mud fluid was placed and the method or methods used in introducing it into the hole. If cement or other plugs were used, state the character of same and depth placed, from feet to feet for each plug set.

# 1 Plug @ 1625' W/65 sacks cement  
# 2 Plug @ 245' W/15 Sacks cement  
# 3 Plug @ 40' W/5 sacks cement


(If additional description is necessary, use BACK of this sheet)

Name of Plugging Contractor Halliburton Co.  
Address Hill City, Kansas

STATE OF Kansas, COUNTY OF Graham, ss.  
Louis Edgett (employee of owner) or (owner or operator) of the above-described well, being first duly sworn on oath, says: That I have knowledge of the facts, statements, and matters herein contained and the log of the above-described well as filed and that the same are true and correct. So help me God.

(Signature) Louis Edgett  
Louis Edgett, Bookkeeper  
P. O. Box D, Hill City, Kansas  
(Address)

SUBSCRIBED AND SWORN to before me this 19th day of December, 19 68

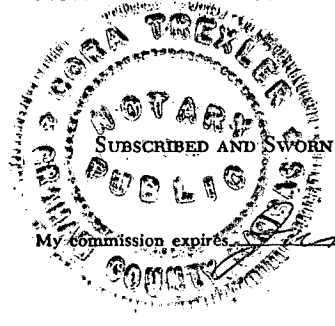

My commission expires 20, 1977

Carroll Taylor Notary Public.

15-179-20169-00-00

CONTRACTOR'S WELL LOG

COMPANY:	BENJAMIN B. TEPPER
CONTRACTOR:	PAINE DRILLING CO., INC.
WELL:	KOSTER # 5
LOCATION:	NW SE NE SEC. 32-8S-29W SHERIDAN COUNTY, KANSAS
COMMENCED:	DECEMBER 8, 1968
COMPLETED:	DECEMBER 16, 1968

0	239	Surface Soil & Sand
239	2757	Shale
2457	2493	Anhydrite
2493	3226	Shale
3226	3954	Lime & Shale
3954	4190	Lime

SET 7" SURFACE PIPE AT 239' W/135 SACKS CEMENT

DRY & ABANDONED

WE HEREBY CERTIFY THAT THE ABOVE IS A CORRECT AND ACCURATE LOG OF THE ABOVE MENTIONED WELL, AS SHOWN ON THE DAILY DRILLING REPORTS.

PAINE DRILLING CO., INC.

BY: Louis Edgett  
LOUIS EDGETT, BOOKKEEPER

SUBSCRIBED AND SWORN TO BEFORE ME THIS 19th DAY OF DECEMBER, 1968.



Louis Tresler  
NOTARY PUBLIC

My Commission Expires January 20, 1972.

12-20-68  
 RECEIVED  
 STATE CORPORATION COMMISSION  
 DEC 20 1968  
 CONSERVATION DIVISION  
 Wichita, Kansas