

For Copy Comm.

SIDE ONE

STATE CORPORATION COMMISSION OF KANSAS
OIL & GAS CONSERVATION DIVISION

WELL COMPLETION OR RECOMPLETION FORM
ACO-1 WELL HISTORY

DESCRIPTION OF WELL AND LEASE

Operator: License # 5027
Name J. A. Allison
Address 300 W. Douglas, Suite 305
City/State/Zip Wichita, Ks. 67202

Purchaser.....

Operator Contact Person J. A. Allison
Phone 316 263-2241

Contractor: License # 5110
Name B & B Drilling, Inc.

Wellsite Geologist Orlin R. Phelps
Phone 316 775-3588

Designate Type of Completion

New Well Re-Entry Workover

Oil SWD Temp Abd
 Gas Inj Delayed Comp.
 Dry Other (Core, Water Supply etc.)

If OWWO: old well info as follows:

Operator.....
Well Name.....
Comp. Date..... Old Total Depth.....

WELL HISTORY

Drilling Method:

Mud Rotary Air Rotary Cable

6-26-85 7-2-85 7-2-85
Spud Date Date Reached TD Completion Date

3998'
Total Depth PBD

Amount of Surface Pipe Set and Cemented at 250 feet
Multiple Stage Cementing Collar Used? Yes No
If yes, show depth set.....feet

If alternate 2 completion, cement circulated
from...surf....feet depth to 250 w/ 170 SX cmt

API NO. 15-065-22,178 -00-00

County Graham

NW NW SW Sec. 33 Twp. 8S Rge. 25W East West

2310 Ft North from Southeast Corner of Section
4950 Ft West from Southeast Corner of Section
(Note: Locate well in section plat below)


Lease Name St. John Well # 1

Field Name.....

Producing Formation.....

Elevation: Ground 2479 KB. 2487

Section Plat

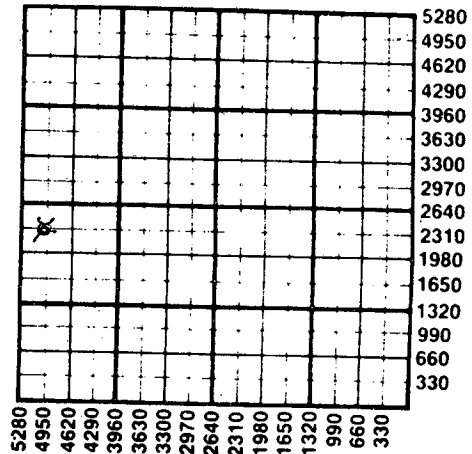

WATER SUPPLY INFORMATION

Disposition of Produced Water: Disposal Repressuring
Docket #.....

Questions on this portion of the ACO-1 call:

Water Resources Board (913) 296-3717

Source of Water:
Division of Water Resources Permit #.....

Groundwater.....Ft North from Southeast Corner
(Well)Ft West from Southeast Corner of
Sec Twp Rge East West

Surface Water.....Ft North from Southeast Corner
(Stream, pond etc).....Ft West from Southeast Corner
Sec Twp Rge East West

Other (explain) hauled
(purchased from city, R.W.D. #)

INSTRUCTIONS: This form shall be completed in duplicate and filed with the Kansas Corporation Commission, 200 Colorado Derby Building, Wichita, Kansas 67202, within 90 days after completion or recompletion of any well. Rule 82-3-130 and 82-3-107 apply.

Information on side two of this form will be held confidential for a period of 12 months if requested in writing and submitted with the form. See rule 82-3-107 for confidentiality in excess of 12 months. One copy of all wireline logs and drillers time log shall be attached with this form. Submit CP-4 form with all plugged wells. Submit CP-111 form with all temporarily abandoned wells.

All requirements of the statutes, rules and regulations promulgated to regulate the oil and gas industry have been fully complied with and the statements herein are complete and correct to the best of my knowledge.

Signature J. A. Allison
Title Operator Date 7/22/85

Subscribed and sworn to before me this 22 day of July 1985
Notary Public Frances O. Erhard

Date Commission Expires January 14, 1986

K.C.C. OFFICE USE ONLY
F Letter of Confidentiality Attached
C Wireline Log Received
C Drillers Timelog Received
Distribution
 KCC SWD/Rep NGPA
 KGS Plug Other (Specify)

FRANCES O. ERHARD
NOTARY PUBLIC
State of Kansas
My Appointment Expires: 1-14-86

Form ACO-1 (7-84) CORPORATION COMMISSION

7-23-85 JUL 23

CONSERVATION DIVISION

