

STATE CORPORATION COMMISSION OF KANSAS
OIL & GAS CONSERVATION DIVISION

WELL COMPLETION OR RECOMPLETION FORM
ACO-1 WELL HISTORY

DESCRIPTION OF WELL AND LEASE

Operator: License #6114
Name ... Don E. Pratt
Address ... P.O. Box 370
..... Hays, KS. 67601
City/State/Zip

Purchaser..... Dry hole

Operator Contact Person Don E. Pratt
Phone 625-3446

Contractor: License #6033
Name ... Murfin Drilling Co

Wellsite Geologist J.R. Green
Phone..... 913-625-9023

Designate Type of Completion
 New Well Re-Entry Workover
 Oil SWD Temp Abd
 Gas Inj Delayed Comp.
 Dry Other (Core, Water Supply etc.)

If OWWO: old well info as follows:
Operator
Well Name
Comp. Date Old Total Depth.....

WELL HISTORY

Drilling Method:
x Mud Rotary Air Rotary Cable
...9-24-85... ..9-27-85... ..9-27-85...
Spud Date Date Reached TD Completion Date
.3642'.....
Total Depth PBDT

Amount of Surface Pipe Set and Cemented at...206 feet
Multiple Stage Cementing Collar Used? Yes No
If yes, show depth set.....feet
If alternate 2 completion, cement circulated
from.....feet depth to.....w/.....SX cmt

API NO. 15-.....179-20,833
County..... Sheridan
440' location East
NE... NE.. NW.. Sec. 22. Twp. 8.. Rge. 26... West

.....415.40 Ft North from Southeast Corner of Section
.....3080 Ft West from Southeast Corner of Section
(Note: Locate well in section plat below)


Lease Name... G. Rabben "B" Well #... 1-22

Field Name.....

Producing Formation..... dry hole

Elevation: Ground...2407.....KB....2412

Section Plat

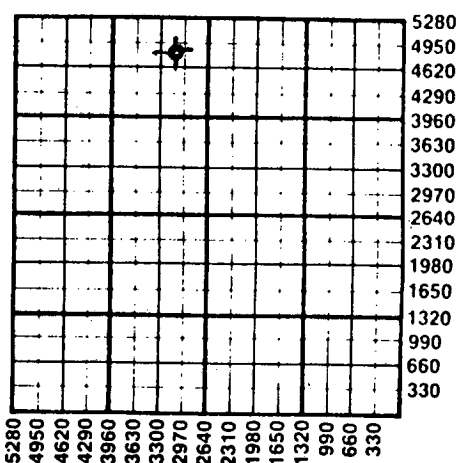

WATER SUPPLY INFORMATION

Disposition of Produced Water: Disposal
Docket # Repressuring

Questions on this portion of the ACO-1 call:
Water Resources Board (913) 296-3717

Source of Water:
Division of Water Resources Permit #.....

Groundwater.....Ft North from Southeast Corner
(Well)Ft West from Southeast Corner of
Sec Twp Rge East West
 Surface Water.....Ft North from Southeast Corner
(Stream, pond etc).....Ft West from Southeast Corner
Sec Twp Rge East West

Other (explain). Solomon Creek - Don E. Pratt
Hays, KS 67601
(purchased from city, R.W.D. #)

INSTRUCTIONS: This form shall be completed in duplicate and filed with the Kansas Corporation Commission, 200 Colorado Derby Building, Wichita, Kansas 67202, within 90 days after completion or recompletion of any well. Rule 82-3-130 and 82-3-107 apply.
Information on side two of this form will be held confidential for a period of 12 months if requested in writing and submitted with the form. See rule 82-3-107 for confidentiality in excess of 12 months.
One copy of all wireline logs and drillers time log shall be attached with this form. Submit CP-4 form with all plugged wells. Submit CP-111 form with all temporarily abandoned wells.


All requirements of the statutes, rules and regulations promulgated to regulate the oil and gas industry have been fully complied with and the statements herein are complete and correct to the best of my knowledge.

Signature *Don E. Pratt* DON E. PRATT

Title..... OPERATOR Date 10-31-85

Subscribed and sworn to before me this 1st day of November, 1985...
Notary Public *Helen Ubert* Helen Ubert

Date Commission Expires...7-22-89

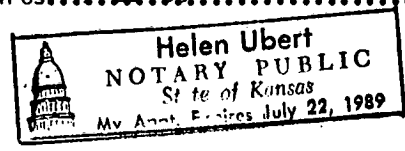

K.C.C. OFFICE USE ONLY
F Letter of Confidentiality Attached
C Wireline Log Received
C Drillers Timelog Received
Distribution
 KCC SWD/Rep NGPA
 KGS Plug Other
(Specify)

RECEIVED
Form ACO-1 (07-84) STATE CORPORATION COMMISSION

NOV 4 1985

Sec 82-3-107
Rge 26
Twp 8
Rge 26

SIDE TWO

Operator Name Don E. Pratt Lease Name C. Robben B. Well # 1-22

Sec. 22 Twp. 8S Rge. 26W East West County Sheridan

WELL LOG

INSTRUCTIONS: Show important tops and base of formations penetrated. Detail all cores. Report all drill stem tests giving interval tested, time tool open and closed, flowing and shut-in pressures, whether shut-in pressure reached static level, hydrostatic pressures, bottom hole temperature, fluid recovery, and flow rates if gas to surface during test. Attach extra sheet if more space is needed. Attach copy of log.

Drill Stem Tests Taken Yes No
 Samples Sent to Geological Survey Yes No
 Cores Taken Yes No

Formation Description
 Log Sample

Name	Top	Bottom
Topeka	3351'	- 930
Heebner	3558	-1146
Toronto	3577	-1165
Lansing KC	3597	-1185
Total Depth	3642	-1230

CASING RECORD New Used

Report all strings set-conductor, surface, intermediate, production, etc.

Purpose of String	Size Hole Drilled	Size Casing Set (in O.D.)	Weight Lbs/Ft.	Setting Depth	Type of Cement	#Sacks Used	Type and Percent Additives
Surface	12 1/2"	8.5/8"	206'	206'	60/40 poz	160	2% gel 3% CC

PERFORATION RECORD

Shots Per Foot	Specify Footage of Each Interval Perforated	Acid, Fracture, Shot, Cement Squeeze Record (Amount and Kind of Material Used)	Depth
.....
.....
.....

TUBING RECORD	Size	Set At	Packer at	Liner Run <input type="checkbox"/> Yes <input type="checkbox"/> No
.....

Date of First Production Producing Method Flowing Pumping Gas Lift Other (explain).....

Estimated Production Per 24 Hours	Oil Bbls	Gas MCF	Water Bbls	Gas-Oil Ratio	Gravity
.....

METHOD OF COMPLETION

Production Interval

Disposition of gas: Vented Sold Used on Lease Open Hole Other (Specify) Perforation Dually Completed Commingled