


Give All Information Completely  
Make Required Affidavit  
Mail or Deliver Report to:  
Conservation Division  
State Corporation Commission  
800 Biting Building  
Wichita, Kansas

OR  
FORMATION PLUGGING RECORD

Strike out upper line  
when reporting plug-  
ging of formations.

NORTH

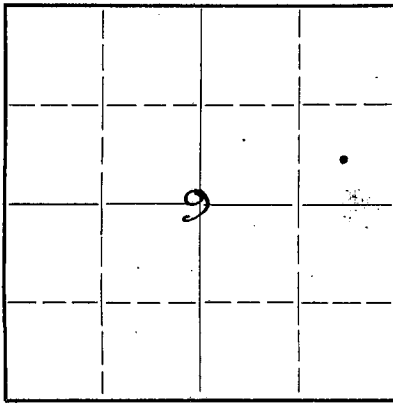

Locate well correctly on above  
Section Plat

Graham County, Sec. 9 Twp. 9 Rge. (E) 21 (W)

Location as "NE 1/4 NW 1/4 SW 1/4" or footage from lines Center SE 1/4 NE 1/4

Lease Owner Hollow Drilling Company, Inc., et al

Lease Name Guy Hedge

Well No. 1

Office Address Inman, Kansas

Character of Well (completed as Oil, Gas or Dry Hole) Dry Hole.

Date well completed 6-13, 1943

Application for plugging filed 6-13, 1943

Application for plugging approved 6-15, 1943

Plugging commenced 6-15, 1943

Plugging completed 6-15, 1943

Reason for abandonment of well or producing formation

Dry Hole

If a producing well is abandoned, date of last production Dry Hole 19

Was permission obtained from the Conservation Division or its agents before plugging was commenced? Yes

Name of Conservation Agent who supervised plugging of this well Burt Stafford Lyons, Ks.

Producing formation Dry Hole Depth to top Bottom Total Depth of Well 3735 Feet

Show depth and thickness of all water, oil and gas formations.


OIL, GAS OR, WATER RECORDS

CASING RECORD

Formation	Content	From	To	Size	Put In	Pulled Out
Surface		0	202	8 5/8"	202'	Left In.

Describe in detail the manner in which the well was plugged, indicating where the mud fluid was placed and the method or methods used in introducing it into the hold. If cement or other plugs were used, state the character of same and depth placed, from..... feet to..... feet for each plug set.

Hole filled with heavy mud from 3735 to 1605. Cement bridge from 1605 to 1565 and filled with heavy mud to 575. Bridge and cement from 575 to 545 and filled with heavy mud to 30'. Bridge and cement from 30' to 6'. Cellar filled with mud.

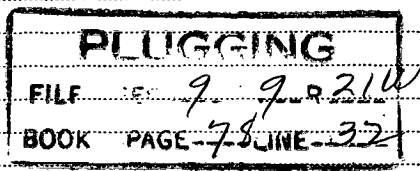

(If additional description is necessary, use BACK of this sheet)

Correspondence regarding this well should be addressed to Hollow Drilling Company, Inc.

Address Inman, Kansas.

STATE OF Kansas, COUNTY OF McPherson, ss.

Frank Leach (employee of owner) or (owner or operator) of the above-described well,

being first duly sworn on oath, says: That I have knowledge of the facts, statements, and matters herein contained and the log of the above-described well as filed and that the same are true and correct. So help me God.

(Signature) [Handwritten Signature]

Inman, Ks.

(Address) Inman, Ks. JUN 19 1943

SUBSCRIBED AND SWORN TO before me this 17th day of June

My commission expires 9-14-46



Notary Public. [Signature]

6-19-43



15-065-02471-0000

HOLLOW DRILLING COMPANY, INC.

Log—Guy Hedge #1,  
Center SE/4 NR/4  
Section 9-95-21w,  
Graham County, Kansas  
590' SL—590' EL NR/4

Elevation: 2145

Casing Record: 8 5/8" Surface,  
Cemented at 202' with 125 sacks cement.

Rotary tools: 0 to 3735'

Date Started—5-26-1943  
Date Completed—6-14-1943

Log	
0	40 Sand
40	960 Shale & Shells
960	1025 Shale & Sand
1025	1095 Shale & Shells
1095	1270 Sand
1270	1605 Shale & Shells
1605	1625 Anhydrite
1625	1644 Sandy Lime
1644	1730 Lime and Shale, Broken
1730	1900 Lime Shells & Shale
1900	1918 Lime
1918	2015 Lime & Shale
2015	2090 Sticky Shale & Lime Shells
2090	2268 Lime & Shale
2268	2296 Shale
2296	2332 Lime
2332	2450 Lime & Shale
2450	2471 Shale
2471	2512 Lime
2512	2555 Shale & Lime Shells
2555	2650 Lime and Broken Shale
2650	2695 Lime & Shale
2695	2710 Shale
2710	2753 Lime & Shale
2753	2836 Lime
2836	2875 Sticky Shale
2875	2920 Sandy Shale
2920	2999 Shale & Lime Broken
2999	3135 Lime & Shale
3135	3185 Broken Lime & Shale
3185	3225 Lime & Shale
3225	3262 Lime
3262	3274 Cherty Lime
3274	3299 Lime
3299	3303 Shale
3303	3307 Lime
3307	3323 Shale
3323	3331 Lime
3331	3341 Shale & Lime
3341	3617 Lime
3617	3640 Lime & Shale
3640	3647 Shale
3647	3657 Lime
3657	3667 Shale
3667	3669 Chert
3669	3674 Shale
3674	3696 Cherty Lime & Shale
3696	3719 Chert
3719	3735 Dolomite

Geological Tops. Derrick Floor

3297	Keobner
3331	Toronto
3331	Base of Oread
3339	Top Lansing
3561	Base Lansing
3665	Conglomerate
3717	Arbuckle

Plugged and Abandoned  
6-14-1943

PLUGGING  
FILE 9-9-214  
BOOK PAGE 78 LINE 32



This certifies that this is a true and correct copy of the log of the Guy Hedge #1 as described above.

*Frank Leach*  
Frank Leach