


15-065-02880-00-00

STATE OF KANSAS  
STATE CORPORATION COMMISSION  
CONSERVATION DIVISION  
P. O. BOX 17027  
WICHITA, KANSAS 67217

FORM CP-4

WELL PLUGGING RECORD

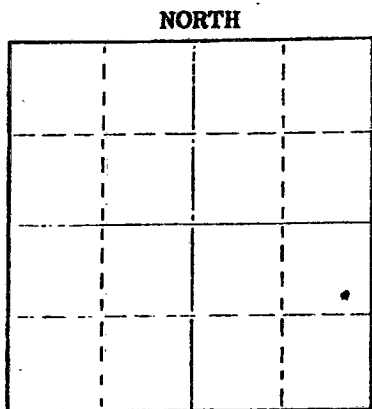

Locate well correctly on above Section Plat

Graham County. Sec. 9 Twp. 9 Rge. (E) 21 (W)

Location as "NE/CNW/SW" or footage from lines C SE NE SE  
Lease Owner Continental Oil Company  
Lease Name Drumm Comm. Co. Well No. 5  
Office Address 3535 N.W. 58th St., Oklahoma City, Oklahoma  
Character of Well (completed as Oil, Gas or Dry Hole) oil 73112  
Date well completed 19  
Application for plugging filed 19  
Application for plugging approved Jan. 28 19 75  
Plugging commenced March 24 19 75  
Plugging completed March 31 19 75  
Reason for abandonment of well or producing formation depleted

If a producing well is abandoned, date of last production 19  
Was permission obtained from the Conservation Division or its agents before plugging was commenced? yes

Name of Conservation Agent who supervised plugging of this well Dale Balthazor  
Producing formation Depth to top Bottom Total Depth of Well 3671 Feet  
Show depth and thickness of all water, oil and gas formations.

OIL, GAS OR WATER RECORDS

CASING RECORD

| FORMATION | CONTENT | FROM | TO    | SIZE    | PUT IN | PULLED OUT |
|-----------|---------|------|-------|---------|--------|------------|
|           |         |      | 382'  | 10 3/4" | 382'   | none       |
|           |         |      | 3666' | 7"      | 3666'  | 786.89     |
|           |         |      |       |         |        |            |
|           |         |      |       |         |        |            |
|           |         |      |       |         |        |            |
|           |         |      |       |         |        |            |

Describe in detail the manner in which the well was plugged, indicating where the mud fluid was placed and the method or methods used in introducing it into the hole. If cement or other plugs were used, state the character of same and depth placed, from feet to feet for each plug set.

Sanded back to 3460' and dumped 4 sacks of cement.  
Sun Cementing plugged well pumping in 4 sacks of hulls, 25 sacks of gel and 200 sacks of cement.

Name of Plugging Contractor PIPE PULLERS, INC.  
Address Box 128, Ellinwood, Kansas 67526

STATE OF KANSAS COUNTY OF BARTON  
Evelyn Roth (employee of owner) or (owner or operator) of the above-described

well, being first duly sworn on oath, says: That I have knowledge of the facts, statements, and matters herein contained and the log of the above-described well as filed and that the same are true and correct. So help me God.

(Signature) Evelyn Roth  
Ellinwood, Kansas

Subscribed and sworn to before me this 3 day of April 19 75

My commission expires  
GEORGE A. MEYER  
STATE NOTARY PUBLIC  
BARTON COUNTY, KANSAS  
MY COMM. EXP. FEB. 10, 1979

George A Meyer  
Notary Public

RECEIVED  
STATE CORPORATION COMMISSION  
APR 4 1975 4-4-75  
CONSERVATION DIVISION  
Wichita, Kansas