


STATE OF KANSAS  
STATE CORPORATION COMMISSION

Give All Information Completely  
Make Required Affidavit  
Mail or Deliver Report to:  
Conservation Division  
State Corporation Commission  
212 North Market, Insurance Bldg.  
Wichita, Kansas

19-065-21362-00-00

WELL PLUGGING RECORD

NORTH

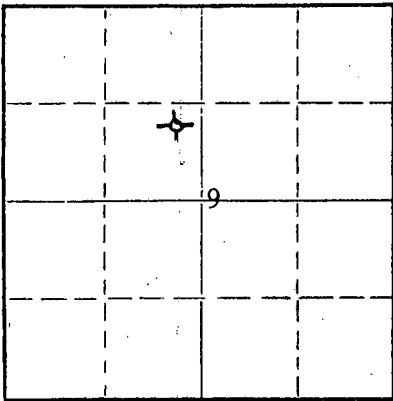

Locate well correctly on above  
Section Plat

Graham County, Sec. 9 Twp. 9S Rge. 21W (EX) (W)  
Location as "NE/CNW%SW%" or footage from lines NE SE NW  
Lease Owner Elk River Oil Company  
Lease Name Clark Well No. #1  
Office Address 300 Farmers & Bankers Bldg., Wichita, KS 67202  
Character of Well (completed as Oil, Gas or Dry Hole) Dry Hole  
Date well completed January 29, 1981  
Application for plugging filed Yes 19  
Application for plugging approved 19  
Plugging commenced 19  
Plugging completed 10:45 a.m., January 29, 1981  
Reason for abandonment of well or producing formation

If a producing well is abandoned, date of last production 19  
Was permission obtained from the Conservation Division or its agents before plugging was commenced? Yes

Name of Conservation Agent who supervised plugging of this well Marion Schmidt  
Producing formation Depth to top Bottom Total Depth of Well Feet  
Show depth and thickness of all water, oil and gas formations.

OIL, GAS OR WATER RECORDS

CASING RECORD

FORMATION	CONTENT	FROM	TO	SIZE	PUT IN	PULLED OUT

Describe in detail the manner in which the well was plugged, indicating where the mud fluid was placed and the method or methods used in introducing it into the hole. If cement or other plugs were used, state the character of same and depth placed, from feet to feet for each plug set.

Plug #1 @ 840' w/60 sx. cement  
Plug #2 @ 210' w/30 sx. cement  
Plug #3 @ 40' w/10 sx. cement

RECEIVED  
STATE CORPORATION COMMISSION

FEB 11 1981

(If additional description is necessary, use BACK of this sheet)  
Name of Plugging Contractor John O. Farmer, Inc. CONSERVATION DIVISION  
Address P.O. Box 352, Russell, KS 67665 Wichita, Kansas

STATE OF Kansas, COUNTY OF Russell, ss. John O. Farmer III (employee or owner) or (owner or operator) of the above-described

well, being first duly sworn on oath, says: That I have knowledge of the facts, statements, and matters herein contained and the log of the above-described well as filed and that the same are true and correct. So help me God.

(Signature) John O. Farmer III  
P.O. Box 352, Russell, KS 67665  
(Address)

SUBSCRIBED AND SWORN TO before me this 10th day of February, 1981

January 27, 1985

Margaret A. Schulte  
Margaret A. Schulte Notary Public.

