

15-065-00181-00-00

STATE OF KANSAS
STATE CORPORATION COMMISSION
Give All Information Completely
Make Required Affidavit
Mail or Deliver Report to:
Conservation Division
State Corporation Commission
800 Bitting Building
Wichita, Kansas

WELL PLUGGING RECORD

Graham County, Sec. 28 Twp. 9 Rge. 21 (W)

Location as "NE/CNW $\frac{1}{4}$ SW $\frac{1}{4}$ " or footage from lines NW NW NE

Lease Owner C-G DRILLING CO., Inc.

Lease Name McDellan Well No. 1

Office Address 206 Union National Bank Bldg.

Character of Well (completed as Oil, Gas or Dry Hole) Dry Hole

Date well completed October 13 19 50

Application for plugging filed October 13 19 50

Application for plugging approved October 13 19 50

Plugging commenced October 13 19 50


Plugging completed October 13 19 50

Reason for abandonment of well or producing formation

too low structurally

If a producing well is abandoned, date of last production 19

Was permission obtained from the Conservation Division or its agents before plugging was commenced? yes

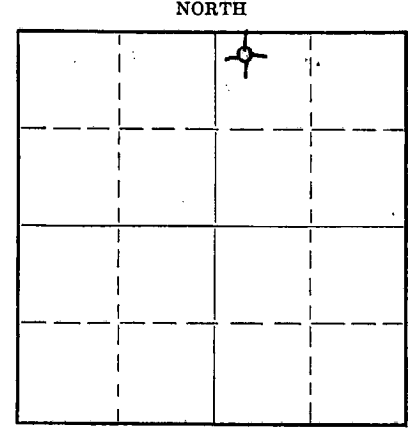

Locate well correctly on above Section Plat

Name of Conservation Agent who supervised plugging of this well Eldon Petty, Hays Kansas

Producing formation Depth to top Bottom Total Depth of Well Feet

Show depth and thickness of all water, oil and gas formations.

OIL, GAS OR WATER RECORDS

CASING RECORD

Formation	Content	From	To	Size	Put In	Pulled Out
				8-5/8" (24#)	265.25'	

Describe in detail the manner in which the well was plugged, indicating where the mud fluid was placed and the method or methods used in introducing it into the hole. If cement or other plugs were used, state the character of same and depth placed, from feet to feet for each plug set.

Filled with drilling mud to 263'. Drove plug to 260'
Put in 15 sacks cement then pumped full of mud 35'
from top of hole. Drove plug down to 35' then filled to
top with 10 sacks of cement

RECEIVED
STATE CORPORATION COMMISSION
OCT 17 1950
CONSERVATION DIVISION
Wichita, Kansas

10-17-50

(If additional description is necessary, use BACK of this sheet)

Correspondence regarding this well should be addressed to C-G Drilling Co., Inc.
Address 206 Union National Bank Bldg., Wichita, Kansas

STATE OF Kansas, COUNTY OF Sedgwick, ss.
R. A. Cook (owner or operator) of the above-described well,
being first duly sworn on oath, says: That I have knowledge of the facts, statements, and matters herein contained and the log of the above-described well as filed and that the same are true and correct. So help me God.

(Signature) R A Cook

206 Union National Bank Bldg. (Address)

SUBSCRIBED AND SWORN to before me this 16th day of October, 1950.

Almeda Sewer Notary Public.



PLUGGING
FILE SEC 28 T 9 R 21 W
BOOK PAGE 35 LINE 40

CONTRACTOR'S WELL LOG

Operator C-G DRILLING CO. Inc. Farm Name McCellan #1
Location NW NW NE Sec. 28-9-21W
Pool Name W. C. County Graham State Kansas
Commencement Date October 4, 1950 Completion Date October 13, 1950

LOG OF WELL

Elevation 2324 D. F.
All measurements from the top of rotary bushing.

DEPTH		FORMATION	DEVIATION	REMARKS:
FROM	TO		FROM	
0	265			
265	920	Shale-shells & Sand		
920-	1154	Sand-Shale		
1154	1245	Sand		
1245	1475	Sand		
1475	1600	Shale-Shells	1500- 0	
1600	1784	Redbed-Sand		
1784	1830	Anhydrite		
1830	1845	Shale		
1845	2250	Shale-Shells		
2250	2420	Lime-Shale		
2420	2540	Lime-Shale		
2540	2685	Lime		
2685	2795	Lime-Shale		
2795	2895	Lime-Shale		
2895	3020	Shale-Lime		
3020	3140	Lime-Shale		
3140	3235	Lime-Shale		
3235	3325	Lime-Shale		
3325	3435	Lime-Shale		
3435	3500	Lime		
3500	3575	Lime		
3575	3635	Lime		
3635	3680	Lime		
3680	3735	Lime		
3735	3790	Lime		
3790	3850	Lime-Shale		
3850	3885	Lime		
3885	3955	Shale-Lime		

RECEIVED
STATE CORPORATION COMMISSION
OCT 17 1950
CONSERVATION DIVISION
Wichita, Kansas
10-17-50

CASING LEFT IN HOLE AFTER COMPLETION

Ran 265.25' (8 Jts) 8 5/8" OD Casing.

STATE OF KANSAS, COUNTY OF SEDGWICK) ss

The undersigned certifies that to the best of his knowledge and belief, the above facts are true and correct.

C-G DRILLING CO. Inc.

By R. A. Ford
President

Subscribed and sworn to before me this 16th day of October, 1950.

My Commission expires:
August 11, 1954

Almeda Love
Notary Public

PLUGGING
FILE SEC 28-9-21W
BOOK PAGE 35 LINE 40