

15-065-00869-0000

WELL PLUGGING RECORD

Give All Information Completely  
Make Required Affidavit  
Mail or Deliver Report to:  
Conservation Division  
State Corporation Commission  
211 No. Broadway  
Wichita, Kansas

Graham County. Sec. 28 Twp. 9S Rge. 21 (E) W (W)

Location as "NE/CNW&SW&" or footage from lines NE NW NW

Lease Owner Peel-Hardman Oil Operators

Lease Name Croffett Well No. 1

Office Address Route #3, Box 144B, Wichita, Kansas

Character of Well (completed as Oil, Gas or Dry Hole) Dry Hole

Date well completed June 10, 1956

Application for plugging filed June 10, 1956

Application for plugging approved June 10, 1956


Plugging commenced June 10, 1956

Plugging completed June 10, 1956

Reason for abandonment of well or producing formation Dry Hole

If a producing well is abandoned, date of last production \_\_\_\_\_ 19\_\_\_\_

Was permission obtained from the Conservation Division or its agents before plugging was commenced? yes

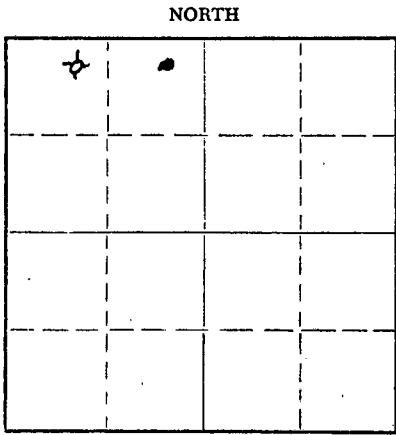

Locate well correctly on above Section Plat

Name of Conservation Agent who supervised plugging of this well \_\_\_\_\_

Producing formation \_\_\_\_\_ Depth to top \_\_\_\_\_ Bottom \_\_\_\_\_ Total Depth of Well 3920 Feet

Show depth and thickness of all water, oil and gas formations.

OIL, GAS OR WATER RECORDS

CASING RECORD

FORMATION	CONTENT	FROM	TO	SIZE	PUT IN	PULLED OUT
		0	193'	8 5/8"	193'	cem.

Describe in detail the manner in which the well was plugged, indicating where the mud fluid was placed and the method or methods used in introducing it into the hole. If cement or other plugs were used, state the character of same and depth placed, from \_\_\_\_\_ feet to \_\_\_\_\_ feet for each plug set.

From 3920' to 186 1/2' - heavy rotary mud  
186 1/2' to 185' - wooden plug  
185' to 139' - 15 sacks cement  
139' to 41 1/2' - heavy rotary mud  
41 1/2' to 40' - wooden plug  
40' to 6' - 10 sacks cement  
6' to surface- cellar

(If additional description is necessary, use BACK of this sheet)

Name of Plugging Contractor Peel Brothers, Inc.

Address P.O. Box 88, Hoisington, Kansas

STATE OF KANSAS, COUNTY OF BARTON, ss.

Peel Brothers, Inc. (employee of owner) or (~~owner or operator~~) of the above-described

well, being first duly sworn on oath, says: That I have knowledge of the facts, statements, and matters herein contained and the log of the above-described well as filed and that the same are true and correct. So help me God. PEEL BROTHERS, INC.

(Signature) BY: Al H. Smith

P.O. BOX 88, Hoisington, Kansas

(Address)

SUBSCRIBED AND SWORN TO before me this 13th day of June, 19 56

Ruth Brank

RECEIVED STATE CORPORATION COMMISSION Notary Public.

JUN 20 1956 6-20-56  
CONSERVATION DIVISION  
Wichita, Kansas

My commission expires April 27, 1960

PLUGGING  
FILE SEC 28 T 9 R 21W  
BOOK PAGE 70 LINE 6

DRILLERS' LOG

Company: Peel-Hardman Oil Operators

NE NW NW

Farm Name: Croffett Well No. 1

Sec. 28, Twp. 9S, Rge. 21W,

Total Depth: 3920'

County: Graham,  
Kansas

Comm: 6/2/56 : Comp: 6/10/56  
Contractor: Peel Brothers, Inc.

Elevation:

Casing: 8 5/8" @ 193' cem.

Production: Dry

Figures below indicate bottoms of formations:

Sand	0 -	40
Shale and shells		440
Shale		800
Shale and sand streaks		1300
Sand, Dakota		1540
Shale		1792
Anhydrite		1822
Shale		2020
Shale and Lime		2510
Lime		2743
Lime and shale		3823
Conglomerate		3920
Total Depth		3920

This is to certify that the above information is to the best of our knowledge, true and correct.

PEEL BROTHERS, INC.

BY: Al H. Smith

SUBSCRIBED AND SWORN to before me this 13th day of June, 1956.

My commission expires: April 27, 1960



Ruth Brink  
Notary Public

PLUGGING  
FILE SEC 28 T 9 R21W  
BOOK PAGE 70 LINE 6

6-20-56