

15-065-30157-00-00


STATE OF KANSAS
STATE CORPORATION COMMISSION

Form CP-4

WELL PLUGGING RECORD

Give All Information Completely
Make Required Affidavit
Mail or Deliver Report to:
Conservation Division
State Corporation Commission
211 No. Broadway
Wichita, Kansas

NORTH

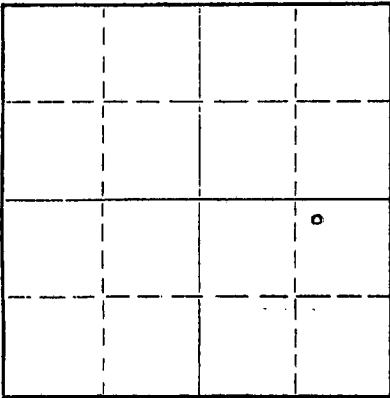

Locate well correctly on above
Section Plat

Graham County, Sec. 1 Twp. 9S Rge. 22 ~~(E)~~ W (W)
Location as "NE/CNW%SW%" or footage from lines NW NE SE
Lease Owner James M. Stewart
Lease Name V. Buss Well No. 1
Office Address 608 Union Center Building, Wichita, Kansas
Character of Well (completed as Oil, Gas or Dry Hole) Dry Hole
Date well completed August 20 19 66
Application for plugging filed by phone August 20 19 66
Application for plugging approved by phone August 20 19 66
Plugging commenced August 20 19 66
Plugging completed 11:30 PM August 20 19 66
Reason for abandonment of well or producing formation Dry Hole

If a producing well is abandoned, date of last production - 19 -
Was permission obtained from the Conservation Division or its agents before plugging was commenced? Yes - by phone

Name of Conservation Agent who supervised plugging of this well W. L. Nichols, Morland, Kansas
Producing formation _____ Depth to top _____ Bottom _____ Total Depth of Well 3860 Feet
Show depth and thickness of all water, oil and gas formations.

OIL, GAS OR WATER RECORDS

CASING RECORD

FORMATION	CONTENT	FROM	TO	SIZE	PUT IN	PULLED OUT
				8-5/8"	252'	None

Describe in detail the manner in which the well was plugged, indicating where the mud fluid was placed and the method or methods used in introducing it into the hole. If cement or other plugs were used, state the character of same and depth placed, from _____ feet to _____ feet for each plug set.

Hole filled with heavy rotary mud to 550 feet;
plug at 550 feet, 25 sacks cement through drill
pipe. Plug and mud to 240 feet, 20 sacks cement
through surface pipe. Plug and bridge at 40 feet
to hold Kelly, 10 sacks cement.

RECEIVED
STATE CORPORATION COMMISSION

AUG 26 1966

CONSERVATION DIVISION
Wichita, Kansas


826-66

(If additional description is necessary, use BACK of this sheet)
Name of Plugging Contractor Gabbert-Jones, Inc.
Address 514 Orpheum Building, Wichita, Kansas

STATE OF Kansas, COUNTY OF Sedgwick, ss.
James M. Stewart (owner or operator) of the above-described well, being first duly sworn on oath, says: That I have knowledge of the facts, statements, and matters herein contained and the log of the above-described well as filed and that the same are true and correct. So help me God.

(Signature) James M. Stewart
608 Union Center Building, Wichita, Kansas
(Address)

SUBSCRIBED AND SWORN TO before me this 25th day of August, 19 66
My commission expires November 14, 1968

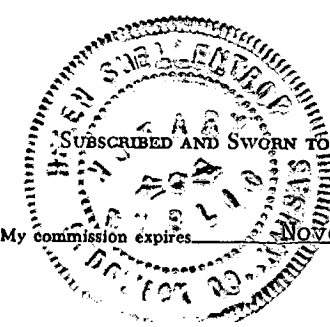

Walter S. [Signature]
Notary Public.

