

15-179-20273-00-00


STATE OF KANSAS
STATE CORPORATION COMMISSION

Form CP-4

Give All Information Completely
Make Required Affidavit
Mail or Deliver Report to:
Conservation Division
State Corporation Commission
212 No. Market
Wichita, Kansas 67202

WELL PLUGGING RECORD

NORTH

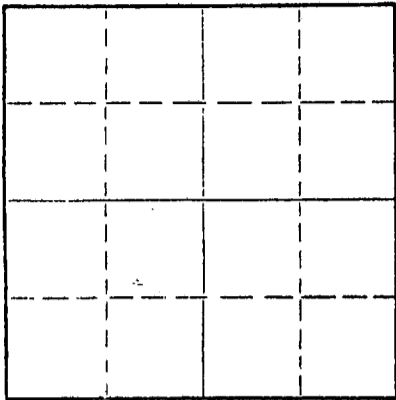

Locate well correctly on above
Section Plat

Sheridan County. Sec. 21 Twp. 8S Rge. (E) 26 (W)
Location as "NE/CNW&SW&" or footage from lines C S/2 SW/4 SE/4
Lease Owner Consolidated Oil & Gas, Inc. & Abercrombie Drlg., Inc.
Lease Name MIZER Well No. 1
Office Address 801 Union Center, Wichita, Kansas 67202
Character of Well (completed as Oil, Gas or Dry Hole) Dry Hole
Date well completed November 1, 1970
Application for plugging filed (verbally) November 1, 1970
Application for plugging approved (verbally) November 1, 1970
Plugging commenced November 1, 1970
Plugging completed November 1, 1970
Reason for abandonment of well or producing formation Dry Hole

If a producing well is abandoned, date of last production 19
Was permission obtained from the Conservation Division or its agents before plugging was commenced? Yes

Name of Conservation Agent who supervised plugging of this well Bill Nichols
Producing formation _____ Depth to top _____ Bottom _____ Total Depth of Well 3940 Feet
Show depth and thickness of all water, oil and gas formations.

OIL, GAS OR WATER RECORDS

CASING RECORD

FORMATION	CONTENT	FROM	TO	SIZE	PUT IN	PULLED OUT
				8 5/8"	246'	None

Describe in detail the manner in which the well was plugged, indicating where the mud fluid was placed and the method or methods used in introducing it into the hole. If cement or other plugs were used, state the character of same and depth placed, from _____ feet to _____ feet for each plug set.

Set 1st plug at 1280' w/50 sx.
Set 2nd plug at 270' w/25 sx.
Set top plug at 40' w/10 sx.
Job completed at 5:30 a.m. 11-1-70.

RECEIVED
STATE CORPORATION COMMISSION
NOV 5 1970
CONSERVATION DIVISION
Wichita, Kansas

11-5-70

(If additional description is necessary, use BACK of this sheet)
Name of Plugging Contractor Abercrombie Drilling, Inc.
Address 801 Union Center, Wichita, Kansas 67202

STATE OF KANSAS, COUNTY OF SEDGWICK, ss.
Jerry A. Langrehr (employee of owner) or (owner or operator) of the above-described well, being first duly sworn on oath, says: That I have knowledge of the facts, statements, and matters herein contained and the log of the above-described well as filed and that the same are true and correct. So help me God.

(Signature) Jerry A. Langrehr
801 Union Center, Wichita, Kansas 67202
(Address)

Subscribed AND SWORN to before me this 3rd day of November, 1970

Sue J. McCoy
Sue J. McCoy Notary Public.

November 12, 1973



15-179-20273-00-00

CONTRACTOR'S WELL LOG

OPERATOR:	Consolidated Oil & Gas, Inc.
CONTRACTOR:	Abercrombie Drilling, Inc.
WELL NAME:	MIZER #1
LOCATION:	C S/2 SW/4 SE/4, Sec. 21-8S-26W Sheridan County, Kansas
GEOLOGIST:	Jack K. Wharton
SPUD DATE:	October 25, 1970
COMPLETION DATE:	November 1, 1970

0	40	Hard Sandstone
40	70	Clay
70	100	Sand
100	1620	Shale
1620	1630	Sand
1630	1760	Shale w/sand streaks
1760	1935	Sand
1935	2155	Shale
2155	2190	Anhydrite
2190	2513	Shale
2513	3190	Shale and Lime
3190	3590	Lime and Shale
3590	3940	Lime
	3940	Rotary Total Depth

RECEIVED
 CORPORATION COMMISSION
 NOV 5 1970
 CONSERVATION DIVISION
 Wichita, Kansas
 11-5-70

Drilled 256' of 12-1/4" surface hole and set casing 8 5-8" @246' w/175 sx. cement. Cement circulated. Plug was down at 5:45 p.m., 10-25-70.
 Dry and Abandoned

<u>ELECTRIC LOG TOPS</u>	<u>ELEVATION</u>
Anhydrite 2155 (+375)	
B/Anhydrite 2189 (+341)	2530 K.B.
Topeka 3464 (-934)	2528 D.F.
Heebner 3671 (-1141)	2522 G.L.
Toronto 3694 (-1164)	
Lansing 3712 (-1182)	
B/Kansas City 3928 (-1412)	

STATE OF KANSAS)
) SS
 COUNTY OF SEDGWICK)

Jerry A. Langrehr, President of Abercrombie Drilling, Inc., does hereby state that the above and foregoing is a true and correct copy of the log of the MIZER #1, C S/2 SW/4 SE/4, Sec. 21-8S-26W, Sheridan County, Kansas.

ABERCROMBIE DRILLING, INC.
 By: Jerry A. Langrehr
 Jerry A. Langrehr
 President

Subscribed and sworn to before me, a Notary Public, in and for the aforesaid county and state as of this 3rd day of November, 1970.

Sue J. McCoy
 Sue J. McCoy, Notary Public

My Commission Expires:
 November 12, 1973