


15-179-20427-00-00

STATE OF KANSAS
STATE CORPORATION COMMISSION

WELL PLUGGING RECORD

Give All Information Completely
Make Required Affidavit
Mail or Deliver Report to
Conservation Division
State Corporation Comm.
245 North Water
Wichita, KS 67202

Sheridan County, Sec. 21 Twp. 8S Rge. 26 W
Location as "NE/CNW $\frac{1}{2}$ /SW $\frac{1}{4}$ " or footage from lines NE SE SE

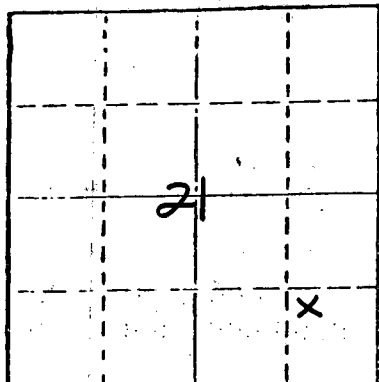

Locate well correctly on above
Section Plot

Lease Owner The Maurice L. Brown Company
Lease Name MIZER Well No. 1
Office Address 1500 Vickers KSB&T Building Wichita, KS 67202
Character of Well (Completed as Oil, Gas or Dry Hole)
Dry Hole

Date Well completed June 14 1976
Application for plugging filed (verbally) June 14 1976
Application for plugging approved (verbally) June 14 1976
Plugging commenced June 14 1976
Plugging completed June 14 1976

Reason for abandonment of well or producing formation
No commercial quantity of gas or oil encountered.
If a producing well is abandoned, date of last production
19

Was permission obtained from the Conservation Division or
its agents before plugging was commenced? Yes

Name of Conservation Agent who supervised plugging of this well Gilbert Balthazor
Producing formation _____ Depth to top _____ Bottom _____ Total Depth of Well 3920'
Show depth and thickness of all water, oil and gas formations.

OIL, GAS OR WATER RECORDS

CASING RECORD

FORMATION	CONTENT	FROM	TO	SIZE	PUT IN	PULLED OUT
				8 5/8"	238.95'	None

Describe in detail the manner in which the well was plugged, indicating where the mud fluid
was placed and the method or methods used in introducing it into the hold. If cement or other
plugs were used, state the character of same and depth placed, from _____ feet to
_____ feet for each plug set.


1st Plug set @ 1400' with 70 sacks
2nd Plug set @ 250' with 20 sacks
3rd Plug set @ 40' with 10 sacks
State Plugger: Gilbert Balthazor
Plug was down @ 9:00 p.m. June 14, 1976.

(If additional description is necessary, use BACK of this sheet)

Name of Plugging Contractor Abercrombie Drilling, Inc.
801 Union Center, Wichita, Kansas 67202

STATE OF KANSAS COUNTY OF SEDGWICK
Jerry A. Langrehr, Exec. V. P. (employee of owner) or (owner or operator) of the above-described
well, being first duly sworn on oath, says: That I have knowledge of the facts, statements, and matters herein contained and the log of the
above-described well as filed and that the same are true and correct. So help me God.

(Signature) Jerry A. Langrehr
801 Union Center, Wichita, Kansas 67202
(Address) _____ 19 76

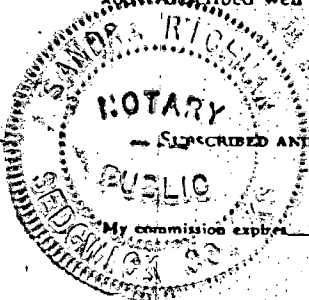

16th day of June 1976
Sandra Richman Notary Public.
My commission expires July 21, 1979

RECEIVED
STATE CORPORATION COMMISSION
JUN 17 1976
6-17-76
CONSERVATION DIVISION
Wichita, Kansas

CONTRACTOR'S WELL LOG

15-179-20427-00-00

OPERATOR: The Maurice L. Brown Company
 CONTRACTOR: Abercrombie Drilling, Inc.
 WELL NAME: MIZER #1
 LOCATION: NE SE SE Section 21-8S-26W
 Sheridan County, Kansas
 GEOLOGIST: Ed Donnelly
 SPUD DATE: June 5, 1976
 COMPLETION DATE: June 14, 1976

0	160	Sand
160	248	Shale
248	1500	Shale & Sand
1500	1710	Shale
1710	1890	Sand
1890	2111	Shale
2111	2145	Anhydrite
2145	2680	Shale
2680	2963	Lime & Shale
2963	3312	Shale & Lime
3312	3720	Lime & Shale
3720	3920	Lime
	3920	Rotary Total Depth

Drilled 248' of 12 1/4" hole. Ran 6 joints of 8 5/8" casing, tallied 238.95'. Cemented with 190 sx. Common cement, 3% ca. cl. Cement did circulate. Drilling @ 600'. Job complete @ 3:00 p.m. 6-6-76.

PLUGGED ABANDONED: 1st Plug was @ 1400' with 70 sx. cement. 2nd Plug was @ 250' with 20 sx. cement. 3rd Plug was @ 40' with 10 sx. cement. State Plugger: Gilbert Balthazor Plug was down @ 9:00 p.m. June 14, 1976.

SAMPLE TOPS:

Anhydrite 2111'
 B/Anhydrite 2145'

STATE OF KANSAS)
) SS
 COUNTY OF SEDGWICK)

Jerry A. Langrehr, Executive Vice President of Abercrombie Drilling, Inc., does hereby state that the above and foregoing is a true and correct copy of the log of the MIZER #1, NE SE SE Section 21-8S-26W, Sheridan County, Kansas.

ABERCROMBIE DRILLING, INC.

By: Jerry A. Langrehr
 Jerry A. Langrehr, Exec. V. P.

Subscribed and sworn to before me, a Notary Public, in and for the aforesaid county and state as of this 16th day of June, 1976.

Sandra Richman
 Sandra Richman, Notary Public

My Commission Expires: July 21, 1979

RECEIVED
 STATE CORPORATION COMMISSION
 6-17-76
 JUN 17 1976

CONSERVATION DIVISION
 Wichita, Kansas