


Give All Information Completely
Make Required Affidavit
Mail or Deliver Report to:
Conservation Division
State Corporation Commission
211 No. Broadway
Wichita, Kansas

Sheridan County, Sec. 25 Twp. 8S Rge. 26W (E) (W)

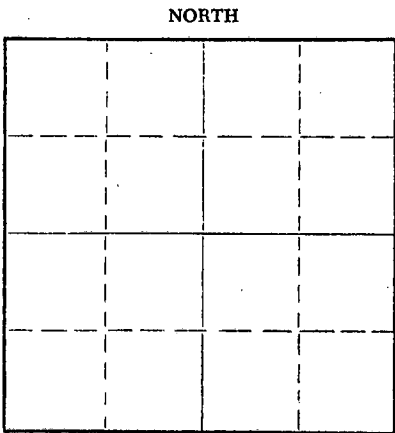

Locate well correctly on above Section Plat

Location as "NE/CNW/SW" or footage from lines. NW/SW/NW
Lease Owner Jones, Shelburne & Farmer
Lease Name Fox Well No. #2
Office Address Russell, Kansas
Character of Well (completed as Oil, Gas or Dry Hole) _____
Date well completed _____ 19____
Application for plugging filed Yes 19____
Application for plugging approved Yes 19____
Plugging commenced _____ 19 58
Plugging completed _____ 19 57
Reason for abandonment of well or producing formation _____

If a producing well is abandoned, date of last production _____ 19____
Was permission obtained from the Conservation Division or its agents before plugging was commenced? Yes

Name of Conservation Agent who supervised plugging of this well Mr. Eldon Petty
Producing formation _____ Depth to top _____ Bottom _____ Total Depth of Well 3960' Feet
Show depth and thickness of all water, oil and gas formations.

OIL, GAS OR WATER RECORDS

CASING RECORD

FORMATION	CONTENT	FROM	TO	SIZE	PUT IN	PULLED OUT
				5 1/2"		2,143'

Describe in detail the manner in which the well was plugged, indicating where the mud fluid was placed and the method or methods used in introducing it into the hole. If cement or other plugs were used, state the character of same and depth placed, from _____ feet to _____ feet for each plug set.

Measured into TD 3960'.
Plugging started 2-8-57. Finished 2-14-57.
Plugged off bottom with sand back to 3740' and dumped 1/2 sacks cement.
Shot 5 1/2" casing at 2,143'. Pulled pipe out of hole and plugged well with heavy mud to 180' and set permanent rock bridge. Dumped 15 sacks cement. Filled hole with mud to 35' and mixed 10 sacks cement for cap on well.

RECEIVED
STATE CORPORATION COMMISSION
FEB 21 1957
CONSERVATION DIVISION
Wichita, Kansas

(If additional description is necessary, use BACK of this sheet)
Name of Plugging Contractor J.O. Forbes d/b/a Forbes Casing Pulling Co.
Address Box 221, Great Bend, Kansas

STATE OF Kansas, COUNTY OF Barton, ss. J.O. Forbes (employee of owner) or (owner or operator) of the above-described well, being first duly sworn on oath, says: That I have knowledge of the facts, statements, and matters herein contained and the log of the above-described well as filed and that the same are true and correct. So help me God.

(Signature) J.O. Forbes
Box 221, Great Bend, Kansas (Address)

SUBSCRIBED AND SWORN TO before me this 19th day of February, 1957.
My commission expires November 8, 1960
Betty S. Edman Notary Public.



PLUGGING
FILE SEC. 25 T. 8 R. 26 W
BOOK PAGE 141 LINE 35

OPERATOR Jones, Shelburne & Farmer, Inc.

15-179-05204-00-00

FORMATION RECORD

ADDRESS Russell, Kansas

Give detailed description and thickness of all formations drilled through, contents of sand, whether dry, water, oil or gas.

640 Acres
N

160		160
160		160

Locate well correctly

COUNTY Sheridan 25 TWP 8 RGE 26COMPANY OPERATING Jones, Shelburne & Farmer, Inc.OFFICE ADDRESS Russell, KansasFARM NAME FOX WELL NO. 2DRILLING STARTED 7-5 55 DRILLING FINISHED 7-14 55

DATE OF FIRST PRODUCTION _____ COMPLETED _____

WELL LOCATED NW 1/4 SW 1/4 NW 1/4 North of South

Line and _____ ft. East of West Line of Quarter Section

Elevation (Relative to sea level) DERRICK FLOOR 2529 GROUND 2524CHARACTER OF WELL (Oil, gas or dryhole) Oil

OIL OR GAS SANDS OR ZONES

Name	From	To	Name	From	To
1			4		
2			5		
3			6		

Perforating Record If Any

Shot Record

Formation	From	To	No. of Shots	Formation	From	To	Size of Shot

CASING RECORD

Amount Set						Amount Pulled		Packer Record			
Size	Wt.	Thds.	Make	Ft.	In.	Ft.	In.	Size	Length	Depth Set	Make
8-5/8				182							

Liner Record: Amount _____ Kind _____ Top _____ Bottom _____

CEMENTING AND MUDDING

Size	Amount Set		Sacks Cement	Chemical		Method of Cementing	Amount	Mudding Method	Results (See Note)
	Ft.	In.		Gal.	Make				
8-5/8	182		125						
5-1/2	3940		100						

Note: What method was used to protect sands if outer strings were pulled? _____

NOTE: Were bottom hole plugs used? _____ If so, state kind, depth set and results obtained _____

TOOLS USED

Rotary Tools were used from _____ feet to _____ feet. Cable tools were used from _____ feet to _____ feet, and from _____ feet to _____ feet, and from _____ feet to _____ feet.

Type Rig _____

INITIAL PRODUCTION TEST

Describe initial test: whether by flow through tubing or casing or by pumping _____

Amount of Oil Production _____ bbls. Size of choke, if any _____ Length of test _____ Water

Production _____ bbls. Gravity of oil _____ Type of Pump if pump is used, describe _____

Formation	Top	Bottom	Formation	Top	Bottom
Sand	0	160			
Shale	160	180			
Shale Shells & Sand Streaks	180	1050			
Shale & sand	1050	1950			
Red Bed & Shale	1950	2171			
Anhydrite	2171	2207			
Shale & shells	2207	2410			
Lime & shale	2410	3375			
Shale & lime	3375	3490			
Lime & shale	3490	3715			
Lime	3715	3750			
Lime & shale	3750	3775			
Lime	3775	3825			
Lime & shale	3825	3955			
Cong.	3955	3960			
T.D.		3960			

TOPS:

Elevation	RB	2591
Anhydrite		2171
Heebner		3677
Lansing		3714
Base/Kansas City		3934
T.D.		3960

RECEIVED
REGISTRATION COMMISSION

FEB 21 1957

REGISTRATION DIVISION
Topeka, Kansas

PLUGGING

FILE SEC 25 T 8 R 26W
BOOK PAGE 141 LINE 35

I, the undersigned, being first duly sworn upon oath, certify that this well record is true, correct and complete according to the records of this office and to the best of my knowledge and belief.

John D. Farmer Vice-Pres.
Name and title of representative of company

Subscribed and sworn to before me this 18th day of July, 19 55
My Commission expires 10-11-58
Lucille Kennedy
Notary Public

WELL NO. 2 COUNTY Sheridan SEC. 25, TWP. 8, RGE. 26 FARM NAME FOX