

15-179-20138-00-00


STATE OF KANSAS  
STATE CORPORATION COMMISSION

Form CP-4

Give All Information Completely  
Make Required Affidavit  
Mail or Deliver Report to:  
Conservation Division  
State Corporation Commission  
212 No. Market  
Wichita, Kansas

WELL PLUGGING RECORD

NORTH

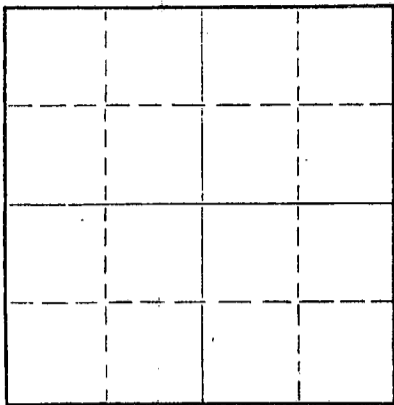

Locate well correctly on above  
Section Plat

Sheridan County, Sec. 5 Twp. 8 Rge. 26 (E) W (W)  
Location as "NE/CNW%SW%" or footage from lines SE SE NE  
Lease Owner Leo J. Dreiling Oil Company  
Lease Name Albers Well No. 1  
Office Address Route 2, Victoria, Kansas 67671  
Character of Well (completed as Oil, Gas or Dry Hole) Dry Hole  
Date well completed 9-23 1968  
Application for plugging filed 9-23 1968  
Application for plugging approved 9-23 1968  
Plugging commenced 9-23 1968  
Plugging completed 9-23 1968  
Reason for abandonment of well or producing formation Dry Hole

If a producing well is abandoned, date of last production 19  
Was permission obtained from the Conservation Division or its agents before plugging was commenced? Yes

Name of Conservation Agent who supervised plugging of this well W. L. Nichols  
Producing formation \_\_\_\_\_ Depth to top \_\_\_\_\_ Bottom \_\_\_\_\_ Total Depth of Well \_\_\_\_\_ Feet  
Show depth and thickness of all water, oil and gas formations.

OIL, GAS OR WATER RECORDS

CASING RECORD

FORMATION	CONTENT	FROM	TO	SIZE	PUT IN	PULLED OUT
Surface Pipe				8 5/8"	201	

Describe in detail the manner in which the well was plugged, indicating where the mud fluid was placed and the method or methods used in introducing it into the hole. If cement or other plugs were used, state the character of same and depth placed, from \_\_\_\_\_ feet to \_\_\_\_\_ feet for each plug set.

1st. plug was set @ 1325' with 70 sacks cement  
2nd. plug was set @ 210' with 20 sacks cement  
3rd. plug was set @ 40' with 1/4 sack hulls and 10 sacks cement  
Cementing to bottom of cellar.

RECEIVED  
STATE CORPORATION COMMISSION  
SEP 25 1968  
CONSERVATION DIVISION  
Wichita, Kansas

9-25-68

(If additional description is necessary, use BACK of this sheet)

Name of Plugging Contractor L. J. Dreiling & Sons, Inc.  
Address Route 2, Victoria, Kansas 67671

STATE OF KANSAS, COUNTY OF ELLIS, ss.  
I, Leo F. Dreiling (employee of owner) or ~~(owner or operator)~~ of the above-described well, being first duly sworn on oath, says: That I have knowledge of the facts, statements, and matters herein contained and the log of the above-described well as filed and that the same are true and correct. So help me God.

(Signature)

Leo F. Dreiling  
LEO F. DREILING, ROUTE 2, VICTORIA, KANSAS 67671  
(Address)

Subscribed and sworn to before me this 24th day of September, 19 68



Joseph A. Hess  
JOSEPH A. HESS Notary Public.

My commission expires September 19, 1970

# L. J. DREILING AND SONS, INC.

Victoria, Kansas 67671

## WELL LOG

Company	Leo J. Dreiling Oil Company	Sec. 5	Twp. 8	Rng. 26
	Route 2			
	Victoria, Kansas 67671			
Farm	Albers No. 1	Location	SE SE NE	
Total Depth	4006'	County	Sheridan	
Comm.	9-17-68	Comp.	9-23-68	
		Elevation:	2572'	K. B.
Contractor	L. J. Dreiling & Sons, Inc.		2569'	D. F.
	Victoria, Kansas 67671		2567'	G. R.
	Casing Record	Cement Record	Production: D & A	
	201' - 8 5/8"	160 sacks cement		

Figures Indicate Bottom of Formations

0'	49'	Surface Soil & Clay
49'	110'	Clay
110'	142'	Clay and Sand Streaks
142'	172'	Sand & Yellow Clay
172'	201'	Blue Shale
201'	1190'	Shale & Sand
1190'	1545'	Shale & Sand
1545'	1850'	Shale & Gyp
1850'	1950'	Sand
1950'	2212'	Shale, Gyp & Streaks of Sand
2212'	2250'	Anhy.
2250'	2305'	Shale & Pyrite
2305'	2780'	Shale & Shells
2780'	3040'	Shale & Lime
3040'	3200'	Lime
3200'	3325'	Lime & Shale
3325'	3630'	Lime
3630'	3780'	Lime & Shale
3780'	4006'	Lime
4006'	T.D.	

STATE OF KANSAS)  
 )ss  
 COUNTY OF ELLIS)

RECEIVED  
 STATE CORPORATION COMMISSION  
 SEP 25 1968  
 CONSERVATION DIVISION  
 Wichita, Kansas  
 9-25-68

I, Leo F. Dreiling, of the L. J. Dreiling & Sons, Inc., upon oath states that the above and foregoing is a true and correct copy from the Daily Drilling Report from your Albers #1.

*Leo F. Dreiling*  
 LEO F. DREILING

Subscribed and sworn to before me this 24th day of September 1968.



*Joseph A. Hess*  
 JOSEPH A. HESS NOTARY PUBLIC

My commission expires: September 19, 1970