


Give All Information Completely  
Make Required Affidavit  
Mail or Deliver Report to:  
Conservation Division  
State Corporation Commission  
212 No. Market  
Wichita, Kansas

WELL PLUGGING RECORD

Sheridan County, Sec. 16 Twp. 8S Rge. 26 (X) (W)

Location as "NE/CNW/SW" or footage from lines NE SE SW  
Lease Owner Joe Katz Oil Account  
Lease Name Claud Bell Well No. 1  
Office Address 7751 Carondelet Avenue, Clayton, Missouri 63105  
Character of Well (completed as Oil, Gas or Dry Hole) Dry Hole  
Date well completed June 29 19 67  
Application for plugging filed June 29 19 67  
Application for plugging approved June 29 19 67  
Plugging commenced June 29, 6:00 a.m. 19 67  
Plugging completed June 29, 7:00 a.m. 19 67  
Reason for abandonment of well or producing formation Dry

If a producing well is abandoned, date of last production 19  
Was permission obtained from the Conservation Division or its agents before plugging was commenced? Yes

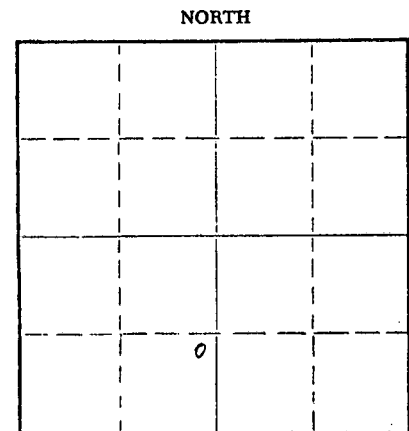

Locate well correctly on above Section Plat

Name of Conservation Agent who supervised plugging of this well Bill Nichols, Morland, Kansas  
Producing formation \_\_\_\_\_ Depth to top \_\_\_\_\_ Bottom \_\_\_\_\_ Total Depth of Well 3588 Feet  
Show depth and thickness of all water, oil and gas formations.

OIL, GAS OR WATER RECORDS

CASING RECORD

FORMATION	CONTENT	FROM	TO	SIZE	PUT IN	PULLED OUT
	Surface	0	211.79	7"	X	

Describe in detail the manner in which the well was plugged, indicating where the mud fluid was placed and the method or methods used in introducing it into the hole. If cement or other plugs were used, state the character of same and depth placed, from \_\_\_\_\_ feet to \_\_\_\_\_ feet for each plug set.

Filled hole with heavy mud to 540', 15 sacks cement thru drill pipe.  
Filled hole with heavy mud to 210', 15 sacks cement with 1/4 sack  
hulls and Howco plug. Filled hole with heavy mud to 40', 10 sacks  
cement. 2 sacks cement in rathole.

RECEIVED  
STATE CORPORATION COMMISSION

JUL 6 1967

CONSERVATION DIVISION  
Wichita, Kansas

4-6-67

(If additional description is necessary, use BACK of this sheet)

Name of Plugging Contractor Sterling Drilling Company  
Address Box 129, Sterling, Kansas 67579

STATE OF KANSAS, COUNTY OF RICE, ss.  
F. A. Wuellner (employee of owner) or (owner or operator) of the above-described well, being first duly sworn on oath, says: That I have knowledge of the facts, statements, and matters herein contained and the log of the above-described well as filed and that the same are true and correct. So help me God. STERLING DRILLING COMPANY

(Signature) F. A. Wuellner  
Box 129, Sterling, Kansas F. A. Wuellner, Secretary  
(Address)

Subscribed and sworn to before me this 5th day of July, 19 67

Bernard Laudermilk  
Bernard Laudermilk, Notary Public.



BERNARD LAUDERMILK, Notary Public  
Commission Expires January 22, 1970

15-179-20023-00-00

STERLING DRILLING COMPANY  
Sterling, Kansas

WELL LOG -----CLAUD BELL #1  
LOCATED: NE SE SW Section 16-8S-26W, Sheridan County, Kansas

OWNER: Joe Katz Oil Account  
ROTARY DRILLING CONTRACTOR: Sterling Drilling Company

COMMENCED: June 24, 1967  
COMPLETED: June 29, 1967

ROTARY TOTAL DEPTH: 3588'

LOG

CASING RECORD

0 - 50	Clay	
50 - 120	Gravel & Sand	
120 - 216	Blue Shale	
216 - 1015	Shale	
1015 - 1595	Shale, Sand & Lime	
1595 - 2112	Sand & Shale	
2112 - 2135	Anhydrite	
2135 - 2794	Shale	
2794 - 3040	Lime & Shale	
3040 - 3162	Lime	
3162 - 3588	Lime & Shale	T.D.

Run 7 joints 7" 20# used seamless casing. 203.29' pipe set at 214.79' K.B., cemented with 150 sacks 50 - 50 Pozmix with 3% HA-5, 4% gel in 1st 100 sacks. Plug was down at 8:15 p.m. by Howco.

**RECEIVED**  
STATE CORPORATION COMMISSION

JUL 6 1967

7-6-67  
CONSERVATION DIVISION  
Wichita, Kansas

Plugged as follows: Heavy mud to 540', 15 sacks cement at 540' thru drill pipe. Mud to 210', 15 sacks cement with 1/4 sack hulls and Howco plug. Mud to 40', 10 sacks cement 40' to 0.