

STATE OF KANSAS
STATE CORPORATION COMMISSION

WELL PLUGGING RECORD

Give All Information Completely
Make Required Affidavit
Mail or Deliver Report to
Conservation Division
State Corporation Comm.
245 North Water
Wichita, KS 67202

Sheridan County, Sec. 17 Twp. 8 Rge. 26 E/W
Location as "NE/CNW 1/4 SW 1/4" or footage from lines
C - N 1/2 - N 1/2 - FSW

Lease Owner Dreiling Oil, Inc.
Lease Name Kysar Well No. 4
Office Address Box 1000, Victoria, KS 67671

Character of Well (Completed as Oil, Gas or Dry Hole)
Oil Well

Date Well completed 10-3-73 19
Application for plugging filed 8-14 1983
Application for plugging approved 8-25 1983
Plugging commenced 11-15 1983
Plugging completed 11-15 1983

Reason for abandonment of well or producing formation
Depleted


If a producing well is abandoned, date of last production
19

Was permission obtained from the Conservation Division or
its agents before plugging was commenced? yes

Name of Conservation Agent who supervised plugging of this well KCC/KDHE Dist. #6

Producing formation _____ Depth to top _____ Bottom _____ Total Depth of Well _____

Show depth and thickness of all water, oil and gas formations.

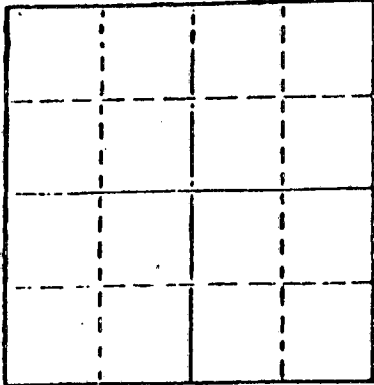

Locate well correctly on above
Section Plot

OIL, GAS OR WATER RECORDS

CASING RECORD

FORMATION	CONTENT	FROM	TO	SIZE	PUT IN	PULLED OUT
Surface casing				8 5/8"	165'	0'
Casing				4 1/2"	3849'	0'

Describe in detail the manner in which the well was plugged, indicating where the mud fluid was placed and the method or methods used in introducing it into the hold. If cement or other plugs were used, state the character of same and depth placed, from _____ feet to _____ feet for each plug set.

Pumped into 4 1/2" 50 sks cement, 3 sks hulls, 10 sks gel, 100 sks cement, 350# pressure. cut hole into 8 5/8", filled 8 5/8" and open hole 4 1/2" to surface with 25 sks cement. Completed @ 10:30 a.m. on 11-15-83


(If additional description is necessary, use BACK of this sheet)

Name of Plugging Contractor Dreiling Oil, Inc.

STATE OF KANSAS COUNTY OF ELLIS, ss.
I, Bill Draper (employee of owner) or (owner or operator)
of the above-described well, being first duly sworn on oath, says: That I have knowledge of the facts, statements, and matters herein contained and the log of the above-described well as filed and that the same are true and correct. So help me God.

(Signature) Bill Draper
Hays, KS 67601 (Address)

SUBSCRIBED AND SWORN TO before me this 16 day of November, 19 83

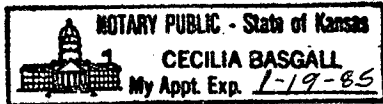

My commission expires

Cecilia Basgall
Notary Public.

RECEIVED
STATE CORPORATION COMMISSION

NOV 17 1983
11-17-1983
CONSERVATION DIVISION
Wichita, Kansas