

15-179-20485-00-00


STATE OF KANSAS
STATE CORPORATION COMMISSION

WELL PLUGGING RECORD

Give All Information Completely
Make Required Affidavit
Mail or Deliver Report to
Conservation Division
State Corporation Comm.
245 North Water
Wichita, KS 67202

Sheridan County, Sec. 19 Twp. 8 S Rge. 26 E/W
Location as "NE/CNW $\frac{1}{4}$ SW $\frac{1}{4}$ " or footage from lines
C NW NE

Lease Owner Voyager Petroleum, Inc.
Lease Name Pfeifer Well No. 1
Office Address 6600 South Yale, Tulsa, Oklahoma 74136
Character of Well (Completed as Oil, Gas or Dry Hole)
Dry Hole

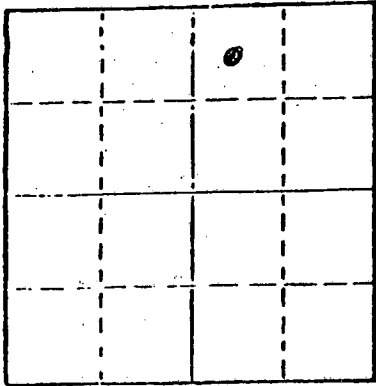

Locate well correctly on above
Section Plat

Date Well completed Oct. 16 19 77
Application for plugging filed (verbally) Oct. 16 19 77
Application for plugging approved (verbally) Oct. 16 19 77
Plugging commenced Oct. 16 19 77
Plugging completed Oct. 16 19 77
Reason for abandonment of well or producing formation
No commercial quantity of oil or gas encountered
If a producing well is abandoned, date of last production 19

Was permission obtained from the Conservation Division or
its agents before plugging was commenced? Yes

Name of Conservation Agent who supervised plugging of this well Gilbert Balthazor
Producing formation _____ Depth to top _____ Bottom _____ Total Depth of Well 4250'
Show depth and thickness of all water, oil and gas formations.

OIL, GAS OR WATER RECORDS

CASING RECORD

FORMATION*	CONTENT	FROM	TO	SIZE	PUT IN	PULLED OUT

Describe in detail the manner in which the well was plugged, indicating where the mud fluid
was placed and the method or methods used in introducing it into the hold. If cement or other
plugs were used, state the character of same and depth placed, from _____ feet to
_____ feet for each plug set.

Set 1st plug at 1000' with 70 sacks
2nd plug at 240' with 20 sacks
3rd plug at 40' with 10 sacks
Cemented with 50/50 posmix, 6% gel.

RECEIVED
STATE CORPORATION COMMISSION

OCT 21 1977

CONSERVATION DIVISION
Wichita, Kansas


10-21-77

(If additional description is necessary, use BACK of this sheet)

Name of Plugging Contractor Abercrombie Drilling, Inc.

STATE OF Kansas COUNTY OF Sedgwick, ss.
Jack L. Partridge, Ass't. Secretary-Treasurer (employee of owner) or (owner or operator)
of the above-described well, being first duly sworn on oath, says: That I have knowledge of
the facts, statements, and matters herein contained and the log of the above-described well
as filed and that the same are true and correct. So help me God.

(Signature) Jack L. Partridge
801 Union Center, Wichita, Kansas 67202
(Address)

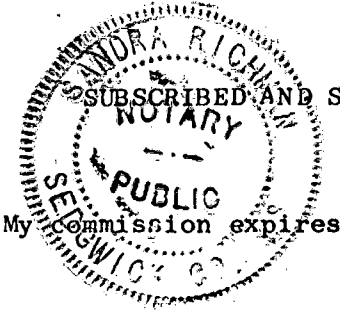

Sandra Richman
Sandra Richman Notary Public.

OPERATOR:
 CONTRACTOR:
 WELL NAME:
 LOCATION:
 SPUD DATE:
 COMPLETION DATE:

Voyager Petroleum, Inc.
 Abercrombie Drilling, Inc.
 Pfeifer #1
 C NW NE Section 19-8S-26W
 Sheridan County, Kansas
 October 7, 1977
 October 16, 1977

0	310	Surface soil, sand & shale
310	650	Shale
650	2104	Shale & sand
2104	2139	Anhydrite
2139	2475	Shale
2475	2647	Lime & shale
2647	2849	Shale
2849	3155	Lime & shale
3155	3435	Shale & lime
3435	3632	Lime & shale
3632	3702	Shale & lime
3702	3828	Shale & lime
3828	3923	Lime & shale
3923	4021	Shale & lime
4021	4250	Lime
	4250	Rotary Total Depth

Spud hole at 4:45 p.m., October 7, 1977. Drilled 310' of 12 1/4" hole. Ran 295.50' of 8-5/8" - 28# surface casing. Set at 303.50' with 250 sacks of common cement, 2% gel, 3% CaCl. Plug was down at 12:00 midnight.

T. D. 4250'. Set 1st plug at 1000' with 70 sacks, 2nd plug at 240' with 20 sacks, 40' solid bridge with 10 sacks. Cemented with 50/50 posmix, 6% gel. Plug was down at 12:30 p.m., October 16, 1977.

SAMPLE TOPS:

Anhydrite 2105'
 B/Anhydrite 2139'

RECEIVED
 STATE CORPORATION COMMISSION

OCT 21 1977

10-21-77

CONSERVATION DIVISION
 Wichita, Kansas

STATE OF KANSAS)
) ss
 COUNTY OF SEDGWICK)


Jack L. Partridge, Assistant Secretary-Treasurer of Abercrombie Drilling, Inc., does hereby state that the above and foregoing is a true and correct copy of the log of the Pfeifer #1, C NW NE Section 19-8S-26W, Sheridan County, Kansas.

ABERCROMBIE DRILLING, INC.

By Jack L. Partridge
 Jack L. Partridge,
 Assistant Secretary-Treasurer

Subscribed and sworn to before me, a Notary Public, in and for the aforesaid county and state, as of this 20th day of October, 1977.

Sandra Richman
 Sandra Richman, Notary Public

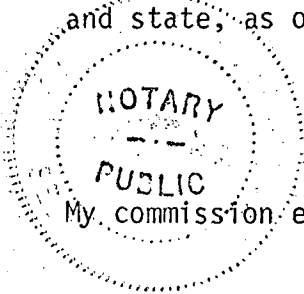

My commission expires July 21, 1979.