


15-179-00172-0000

WELL PLUGGING RECORD

Give All Information Completely
Make Required Affidavit
Mail or Deliver Report to:
Conservation Division
State Corporation Commission
211 No. Broadway
Wichita, Kansas

Sheridan County. Sec. 36 Twp. 8S Rge. 27 (E) W (W)
Location as "NE/CNW/SW" or footage from lines NW/4 SE/4 SW/4
Lease Owner Heathman-Seeligson Drilling Co.
Lease Name BROWN "D" Well No. 1
Office Address 1015 E. Second, Wichita, Kansas
Character of Well (completed as Oil, Gas or Dry Hole) Dry Hole
Date well completed 5-28- 19 56
Application for plugging filed 5-28- 19 56
Application for plugging approved 5-28- 19 56
Plugging commenced 5-28- 19 56
Plugging completed 5-28- 19 56
Reason for abandonment of well or producing formation Dry and Abandoned

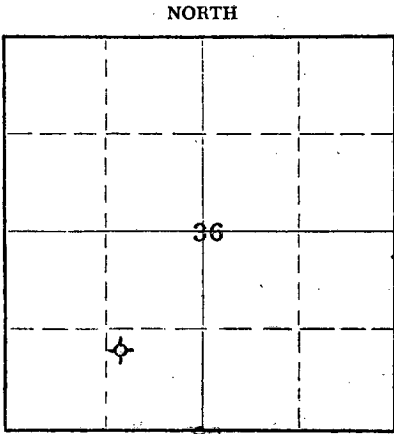

If a producing well is abandoned, date of last production ----- 19 ---
Was permission obtained from the Conservation Division or its agents before plugging was commenced? yes

Name of Conservation Agent who supervised plugging of this well Eldon Petty, Box 326, Hays, Kansas
Producing formation ----- Depth to top -- Bottom -- Total Depth of Well 411 Feet
Show depth and thickness of all water, oil and gas formations.

OIL, GAS OR WATER RECORDS

CASING RECORD

FORMATION	CONTENT	FROM	TO	SIZE	PUT IN	PULLED OUT
-----	-----	-----	-----	8-5/8 used csg.		
				cemented at 294.88'		
				w/175 sx. of sx.		
				cement and 3 Calcium Chloride.		

Describe in detail the manner in which the well was plugged, indicating where the mud fluid was placed and the method or methods used in introducing it into the hole. If cement or other plugs were used, state the character of same and depth placed, from ----- feet to ----- feet for each plug set.

Filled hole w/heavy mud. Set bottom plug at 290' w/1/2 sx. hulls and 15 sx. cement. Filled hole to 40'. Set plug w/1/2 sx. hulls and 10 sx. cement.

(If additional description is necessary, use BACK of this sheet)

Name of Plugging Contractor Heathman-Seeligson Drilling Co.
Address 1015 E. Second, Wichita, Kansas


STATE OF Kansas COUNTY OF Sedgwick, ss.
H. E. Turner (employee of owner) ~~(owner)~~ ~~(operator)~~ of the above-described well, being first duly sworn on oath, says: That I have knowledge of the facts, statements, and matters herein contained and the log of the above-described well as filed and that the same are true and correct. So help me God.

(Signature) [Signature]
1015 E. Second, Wichita, Kansas
(Address)

SUBSCRIBED AND SWORN to before me this 6 day of June, 19 56
My commission expires April 3, 1960
Patricia J. Lamkin
Notary Public.



PLUGGING
FILE SEC. 36T 8 R27W
BOOK PAGE 66 LINE 33

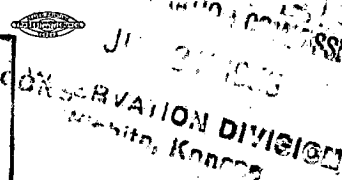

6-8-56

15-179-00172-00-00

DRILLERS' LOG

NAME: BROWN "D" #1 DATE SPUDDED: 5-17-56

LOCATION: NW/4 SE/4 SW/4 Sec.36-88-27W Sheridan County, Kansas ROTARY COMPLETED: 5-28-56

OPERATOR: Heathman-Seeligson Drilling Co. ELEVATION: 2654 GR
2656 DF
2659 KB

CONTRACTOR: Heathman-Seeligson Drilling Co. ROTARY TOTAL DEPTH: 4111'

SURFACE CASING: Ran 14 jts. 8-5/8" used casing cemented at 294.88' w/175 sacks of sack cement and 3 Calcium Chloride. Cement Circulated.

OIL STRING: None - Dry and abandoned 5-28-56

DRILL STEM TESTS

DST #1, 3865-60 open 35 min., rec. 10' mud. BHP-1310#

DST #2, 3888-3912 open 30 min. no blow. Rec. 1' mud w/very few oil specs. IFF-0#, FFP-0#, BHP-0#.

DST #3, 3983-4010 open 30 min. no blow, rec. 4' mud. BHP-1030#

GEOLOGICAL TOPS (KB)

Neebner 3792 (-1133)
Toronto 3818 (-1159)
Lansing 3832 (-1173)
Base Kansas City 4054 (-1395)
R.T.D. 4111

L O G

(Figures indicate bottom of formation)

Clay & Sand	0 - 40
Shale & Shells	130
Sand	260
Shale & Shells	1200
Shale & Sand	1415
Shale	1596
Shale & Shells	1755
Blain Anhydrite	1790
Shale & Red Bed	2271
Anhydrite	2310
Shale & Shells	2356
Shale	2530
Shale & Shells	2825
Shale & Lime	3300
Lime	3395
Shale & Lime	3851
Lime	4085
Lime & Shale	4111

The undersigned, H. E. Turner, hereby certifies that the above log is a true and correct log of the formations encountered in drilling the above noted well as reflected by the Daily Drilling Report.

HEATHMAN-SEELIGSON DRILLING CO.

By: *H. E. Turner*

Subscribed and sworn to before me the 6th day of June, 1956.

Catherine H. Lambert
Notary Public

My Commission expires: April 3, 1960

STAT

6-8-56

PLUGGING
FILE SEC. 36 T. 8 R. 27W
BOOK PAGE 66 LINE 33