

15-179-20019-00 00


STATE OF KANSAS
STATE CORPORATION COMMISSION

Form CP-4

Give All Information Completely
Make Required Affidavit
Mail or Deliver Report to:
Conservation Division
State Corporation Commission
212 No. Market
Wichita, Kansas

WELL PLUGGING RECORD

NORTH

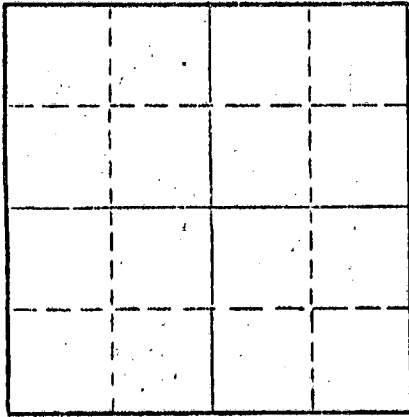

Locate well correctly on above
Section Plat

Sheridan County, Sec. 2 Twp. 8S Rge. (E) 28 (W)
Location as "NE/CNW/SW" or footage from lines C SE SE
Lease Owner Pickrell Drilling Company
Lease Name Weis Well No. 1
Office Address 705 Fourth Nat'l Bank Bldg., Wichita, Kansas 67202
Character of Well (completed as Oil, Gas or Dry Hole) Dry Hole
Date well completed June 29, 19 67
Application for plugging filed June 29, 19 67
Application for plugging approved June 29, 19 67
Plugging commenced June 29, 19 67
Plugging completed June 29, 19 67
Reason for abandonment of well or producing formation Dry Hole

If a producing well is abandoned, date of last production 19
Was permission obtained from the Conservation Division or its agents before plugging was commenced? Yes

Name of Conservation Agent who supervised plugging of this well W. L. Nichols, Box 157, Morland, Kansas
Producing formation Depth to top Bottom Total Depth of Well 4525 Feet
Show depth and thickness of all water, oil and gas formations.

OIL, GAS OR WATER RECORDS

CASING RECORD

FORMATION	CONTENT	FROM	TO	SIZE	PUT IN	PULLED OUT
				8 5/8"	259'	None

Describe in detail the manner in which the well was plugged, indicating where the mud fluid was placed and the method or methods used in introducing it into the hole. If cement or other plugs were used, state the character of same and depth placed, from feet to feet for each plug set.

Heavy mud to 600'. Set plug. Cemented with 30 sacks cement. Heavy mud to 270'. Set plug. Cemented with 25 sacks cement. Heavy mud to 40'. Set plug. Cemented with 10 sacks cement to bottom of cellar. Plugged rat hole with 2 sacks cement.

RECEIVED
STATE CORPORATION COMMISSION
JUL 14 1967
CONSERVATION DIVISION
WICHITA, KANSAS

17-14-67

(If additional description is necessary, use BACK of this sheet)

Name of Plugging Contractor Pickrell Drilling Company
Address 705 Fourth National Bank Bldg., Wichita, Kansas 67202


STATE OF Kansas, COUNTY OF Sedgwick, ss.
C. W. Sebts (owner or operator) of the above-described

sworn on oath, says: That I have knowledge of the facts, statements, and matters herein contained and the log of the described well filed and that the same are true and correct. So help me God.

(Signature) C. W. Sebts
705 4th Nat'l Bank Bldg., Wichita, Ks. 67202
(Address)

Sworn to before me this 11th day of July, 19 67

L. M. Whiting
Notary Public.

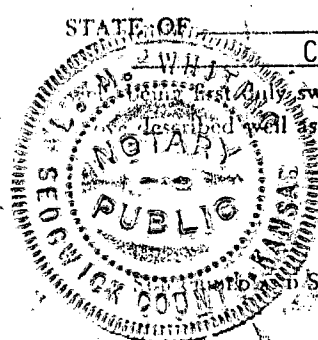

My commission expires May 10, 1970

ROTARY DRILLING LOG

COMPANY: Pickrell Drilling Company
705 Fourth National Bank Bldg.
Wichita, Kansas 67202

Rotary Drilling Commenced 6/20/67

Rotary Drilling Completed 6/29/67

LOCATION: Weis No. 1
C SE SE Section 2-8S-28W
Sheridan County, Kansas

CONTRACTOR: **PICKRELL DRILLING COMPANY**
Wichita, Kansas

CASING RECORD: (12 jts.) 8 5/8" surface casing set at 259' and cemented with 160 sacks cement. Circulated. Complete @ 1:15 PM, 6/20/67. No oil string was run. D. & A., plugged 11:30 PM, 6/29/67.

LOG

(Figures indicate bottom of formation — measurements from top of rotary bushing.)

215	Clay	<u>C. F. S.</u>
1650	Shale & Shells	3573'
1860	Sand	3580'
2005	Shale & Shells	3590'
2075	Shale, Shells & Red Beds	3605'
2230	Sand	3625'
2435	Shale, Shells & Red Beds	3660'
2470	Anhydrite	3695'
2715	Shale & Shells	3710'
3035	Lime & Shale	3730'
3100	Lime	3785'
3315	Lime & Shale	3920'
3400	Shale, Lime & Pyrite	3940'
4455	Lime & Shale	3975'
4525	Mississippi, RTD	4020'
		4043'
		4070'
		4105'
		4130'
		4150'
		4162'
		4275'
		4380'
		4410'
		4450'
		4475'
		4525'

RECEIVED
CORRELATION COMMISSION

JUL 14 1967

7-14-67

CORRELATION DIVISION
Wichita, Kansas

Slope Tests

S. L. M.

2500
3000
3500
4000
4500

3270'

The undersigned, C. W. Sebitts, Attorney-in-Fact for PICKRELL DRILLING COMPANY, hereby certifies in behalf of said Company, that the above is a true and correct log of the formation encountered in drilling the above well as reflected by the Daily Drilling Reports.

PICKRELL DRILLING COMPANY

By [Signature]
C. W. Sebitts Attorney-in-Fact

STATE OF KANSAS }
COUNTY OF SEDGWICK } ss.:

On this 11th day of July, 1967, before me the undersigned, a Notary Public, in and for the County and State aforesaid, personally appeared C. W. Sebitts, to me known to be the identical person who subscribed the name of PICKRELL DRILLING COMPANY to the foregoing instrument as its Attorney-in-Fact and acknowledged to me that he executed the same as his free and voluntary act and deed, and as the free and voluntary act and deed of such company, for the uses and purposes therein set forth.

Given under my hand and seal of office the day and year last above written.

My commission expires: May 10, 1970

[Signature]
L. M. Whiting, Notary Public