

15-179-20102-00-00

Give All Information Completely  
Make Required Affidavit  
Mail or Deliver Report to:  
Conservation Division  
State Corporation Commission  
212 No. Market  
Wichita, Kansas

WELL PLUGGING RECORD

Sheridan County. Sec. 13 Twp. 8S Rge. (E) 28 (W)

Location as "NE/CNW $\frac{1}{4}$ /SW $\frac{1}{4}$ " or footage from lines C NE NW

Lease Owner Rains & Williamson Oil Co., Inc.

Lease Name McKINNEY Well No. 1

Office Address 1425 Wichita Plaza - Wichita, Kansas

Character of Well (completed as Oil, Gas or Dry Hole) Dry Hole

Date well completed 5-21 19 68

Application for plugging filed 5-21 19 68

Application for plugging approved 5-21 19 68


Plugging commenced 5-21 19 68

Plugging completed 5-21 19 68

Reason for abandonment of well or producing formation No oil or gas found in commercial quantities.

If a producing well is abandoned, date of last production None 19     

Was permission obtained from the Conservation Division or its agents before plugging was commenced? Yes

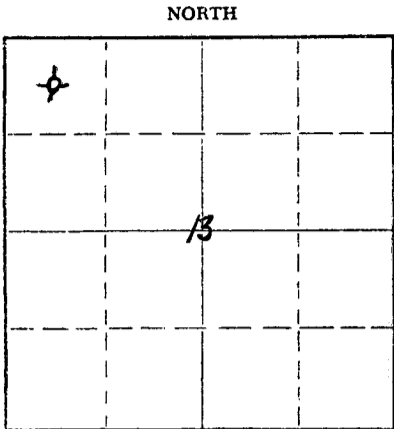

Locate well correctly on above Section Plat

Name of Conservation Agent who supervised plugging of this well Bill Nichols, Moreland, Kansas

Producing formation      Depth to top      Bottom      Total Depth of Well 4097 Feet

Show depth and thickness of all water, oil and gas formations.

OIL, GAS OR WATER RECORDS

CASING RECORD

FORMATION	CONTENT	FROM	TO	SIZE	PUT IN	PULLED OUT
				8-5/8"	236'	-0-

Describe in detail the manner in which the well was plugged, indicating where the mud fluid was placed and the method or methods used in introducing it into the hole. If cement or other plugs were used, state the character of same and depth placed, from      feet to      feet for each plug set.

Spotted 100 sacks 50-50 Pozmix (6% gel) at 1320'. Mud back to 240 feet. Spotted 20 sacks of same. Mud back to 40 feet. Set solid bridge and capped with 10 sacks. Plugging completed 8:15 PM, 5-21-68.

RECEIVED  
STATE CORPORATION COMMISSION  
JUN 3 1968  
CONSERVATION DIVISION  
Wichita, Kansas

(If additional description is necessary, use BACK of this sheet)  
Name of Plugging Contractor Rains & Williamson Oil Co., Inc. 6-3-68  
Address 1425 Wichita Plaza - Wichita, Kansas

STATE OF KANSAS, COUNTY OF SEDGWICK, ss.  
Wilson Rains (employee of owner) or (owner or operator) of the above-described well, being first duly sworn on oath, says: That I have knowledge of the facts, statements, and matters herein contained and the log of the above-described well as filed and that the same are true and correct. So help me God.

(Signature) Wilson Rains Wilson Rains  
1425 Wichita Plaza - Wichita, Kansas  
(Address)

SUBSCRIBED AND SWORN to before me this 29 day of May, 19 68  
My commission expires 6-30-71  
Sherry Gish Notary Public.



15-179-20102-00-00

ROTARY DRILLING LOG

Operator: Rains & Williamson Oil Co., Inc.  
McKINNEY #1  
C NE NW 13-8S-28W  
Sheridan Co., Kansas

Contractor: Rains & Williamson Oil Co., Inc.  
Commenced: 5-14-68  
Completed: 5-21-68  
Remarks: Set 8-5/8" surface casing at 236' w/ 175 sacks cmt.

Formations

Clay	40'
Sand	57'
Sand and Shale	140'
Shale	2005'
Sand	2120'
Shale	2336'
Anhydrite	2372'
Shale and Lime	3850'
Lime	4097'
Rotary Total Depty (D & A)	4097'

RECEIVED  
STATE CORPORATION COMMISSION  
JUN 3 1968  
CONSERVATION DIVISION  
Wichita, Kansas  
6-3-68

We certify the above log is true and correct to the best of our knowledge and belief.

RAINS & WILLIAMSON OIL CO., INC.

Wilson Rains  
Wilson Rains

Subscribed and sworn to before me, a Notary Public within and for the State of Kansas, County of Sedgwick, this 29th day of May, 1968.

Sherry Gish  
Sherry Gish Notary Public

My Commission Expires:  
6-30-71

