

STATE OF KANSAS
STATE CORPORATION COMMISSION

Give All Information Completely
Make Required Affidavit
Mail or Deliver Report to:
Conservation Division
State Corporation Commission
212 North Market, Insurance Bldg.
Wichita, Kansas

15-179-20404-0000

WELL PLUGGING RECORD

Sheridan County, Sec. 19 Twp. 8S Rge. 28W (E) (W)

Location as "NE/CNW/SW" or footage from lines C SW SE

Lease Owner John O. Farmer, Inc.

Lease Name Geist Well No. #1

Office Address Box 352 Russell, Kansas 67665

Character of Well (completed as Oil, Gas or Dry Hole) D & A

Date well completed 19

Application for plugging filed 19

Application for plugging approved 19


Plugging commenced 19

Plugging completed 8:00 P.M. 7/3/75 19

Reason for abandonment of well or producing formation

If a producing well is abandoned, date of last production 19

Was permission obtained from the Conservation Division or its agents before plugging was commenced? Yes

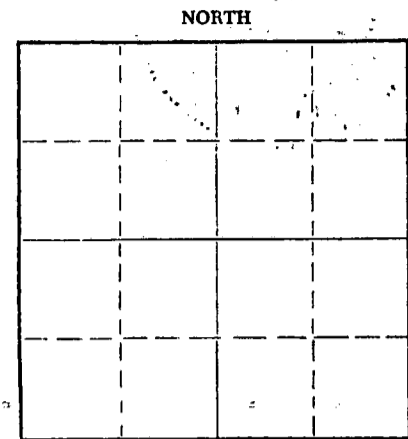

Locate well correctly on above Section Plat

Name of Conservation Agent who supervised plugging of this well Gilbert Balthazor, Palco, Kansas

Producing formation Depth to top Bottom Total Depth of Well Feet

Show depth and thickness of all water, oil and gas formations.

OIL, GAS OR WATER RECORDS

CASING RECORD

FORMATION	CONTENT	FROM	TO	SIZE	PUT IN	PULLED OUT

Describe in detail the manner in which the well was plugged, indicating where the mud fluid was placed and the method or methods used in introducing it into the hole. If cement or other plugs were used, state the character of same and depth placed, from feet to feet for each plug set.

- Plug #1 1300' w/ 70 sx. cement
- Plug #2 200' w/ 20 sx. cement
- Plug #3 40' w/ 10 sx. cement

Completed 8:00 P.M. July 3, 1975

Gilbert Balthazor, State Plugger

RECEIVED
STATE CORPORATION COMMISSION

JUL 10 1975

CONSERVATION DIVISION
Wichita, Kansas

7-16-75

(If additional description is necessary, use BACK of this sheet)

Name of Plugging Contractor John O. Farmer, Inc.
Address Box 352 Russell, Kansas 67665

STATE OF KANSAS, COUNTY OF RUSSELL, ss.

John O. Farmer (employee of owner) or (owner or operator) of the above-described

well, being first duly sworn on oath, says: That I have knowledge of the facts, statements, and matters herein contained and the log of the above-described well as filed and that the same are true and correct. So help me God.


(Signature) John O. Farmer President

Box 352 Russell, Kansas 67665 (Address)

Subscribed and Sworn to before me this 8th day of July, 1975

My commission expires February 15, 1979

Helen Carlson Notary Public.

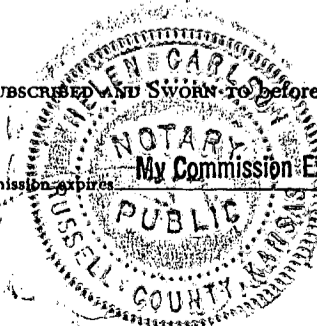


KANSAS DRILLERS LOG

S. 19 T. 8S R. 28W E

Loc. C SW SE

County Sheridan

640 Acres
N

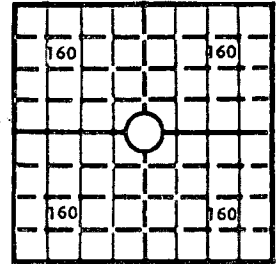

Elev.: Gr. 2721'

DF 2724' KB 2726'

API No. 15 — 179 — 20404-00-00
County Number

Operator
John O. Farmer, Inc.

Address
Box 352 Russell, Kansas

Well No. #1 Lease Name Geist

Footage Location
660 S feet from XN (S) line 660 W feet from OX (W) line

Principal Contractor John O. Farmer, Inc. Geologist Sam Farmer

Spud Date 6-27-75 Total Depth 3890' P.B.T.D.

Date Completed 7-3-75 Oil Purchaser

CASING RECORD

Report of all strings set — surface, intermediate, production, etc.

Purpose of string	Size hole drilled	Size casing set (in O.D.)	Weight lbs/ft.	Setting depth	Type cement	Sacks	Type and percent additives
Surface	12 1/4	8 5/8	26	215	Comon	175	

LINER RECORD

PERFORATION RECORD

Top, ft.	Bottom, ft.	Sacks cement	Shots per ft.	Size & type	Depth interval

TUBING RECORD

Size	Setting depth	Packer set at

ACID, FRACTURE, SHOT, CEMENT SQUEEZE RECORD

CONSERVATION DIVISION
Wichita, Kansas

Amount and kind of material used	Depth interval treated

INITIAL PRODUCTION

Date of first production		Producing method (flowing, pumping, gas lift, etc.)			
RATE OF PRODUCTION PER 24 HOURS	Oil	Gas	Water	Gas-oil ratio	
	bbls.	MCF	bbls.	CFPB	
Disposition of gas (vented, used on lease or sold)			Producing interval (s)		

INSTRUCTIONS: As provided in KCC Rule 82-2-125, within 90 days after completion of a well, one completed copy of this Drillers Log shall be transmitted to the State Geological Survey of Kansas, 4150 Monroe Street, Wichita, Kansas 67209. Copies of this form are available from the Conservation Division, State Corporation Commission, 3830 So. Meridian (P.O. Box 17027), Wichita, Kansas 66217. Phone AC 316-522-2206. If confidential custody is desired, please note Rule 82-2-125. Drillers Logs will be on an open file in the Oil and Gas Division, State Geological Survey of Kansas, Lawrence, Kansas 66044.

Operator **John O. Farmer, Inc.** DESIGNATE TYPE OF COMP.: OIL, GAS, DRY HOLE, SWDW, ETC.: **Dry Hole**

Well No. **#1** Lease Name **Geist**

S 19 T 8S R 28 ^{EX} W

WELL LOG

Show all important zones of porosity and contents thereof; cored intervals, and all drill-stem tests, including depth interval tested, cushion used, time tool open, flowing and shut-in pressures, and recoveries.

SHOW GEOLOGICAL MARKERS, LOGS RUN, OR OTHER DESCRIPTIVE INFORMATION.

FORMATION DESCRIPTION, CONTENTS, ETC.	TOP	BOTTOM	NAME	DEPTH
Shale and Sand	0	217	Anhydrite	2416+310
Shale	217	850	Topeka	3664-938
Shale and Sand	850	1880	Heebner	3878-1152
Shale	1880	2100	T.D.	3890-1164
Sand	2100	2210		
Red Bed	2210	2416		
Anhydrite	2416	2452		
Shale	2452	2490		
Shale and Shells	2490	2895		
Lime and Shale	2895	3205		
Shale and Lime	3205	3295		
Lime and Shale	3295	3710		
Lime	3710	3890		
Total Depth	3890			

USE ADDITIONAL SHEETS, IF NECESSARY, TO COMPLETE WELL RECORD.

Date Received

Sam Farmer
 Signature
 Geologist
 Title
 July 8, 1975
 Date