


WELL PLUGGING RECORD

Give All Information Completely
Make Required Affidavit
Mail or Deliver Report to:
Conservation Division
State Corporation Commission
211 No. Broadway
Wichita, Kansas

Sheridan County, Sec. 31 Twp. 8S Rge. 28 (E) W (W)
Location as "NE/CNW/SW" or footage from lines Center NW/4 SE/4
Lease Owner Heathman-Seeligson Drilling Co.
Lease Name CLARK "E" Well No. 1
Office Address 1015 E. Second, Wichita, Kansas
Character of Well (completed as Oil, Gas or Dry Hole) Dry Hole
Date well completed 11-10- 19 56
Application for plugging filed 11-10- 19 56
Application for plugging approved 11-10- 19 56
Plugging commenced 11-10- 19 56
Plugging completed 11-10- 19 56
Reason for abandonment of well or producing formation Dry and abandoned

If a producing well is abandoned, date of last production ----- 19 ---
Was permission obtained from the Conservation Division or its agents before plugging was commenced? yes

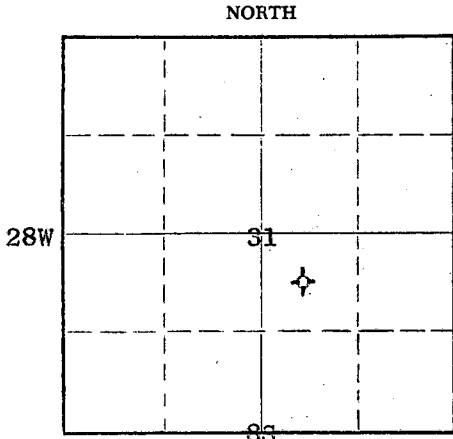

Locate well correctly on above Section Plat

Name of Conservation Agent who supervised plugging of this well Eldon Petty, Box 326, Hays, Kansas
Producing formation ----- Depth to top -- Bottom --- Total Depth of Well 4434 Feet
Show depth and thickness of all water, oil and gas formations.

OIL, GAS OR WATER RECORDS

CASING RECORD

FORMATION	CONTENT	FROM	TO	SIZE	PUT IN	PULLED OUT
-----	-----	----	----	8-5/8 used csg.		
				cemented at 241.89'		
				w/170 sx. of sx.		
				cement & 2 Calcium Chloride.		

Describe in detail the manner in which the well was plugged, indicating where the mud fluid was placed and the method or methods used in introducing it into the hole. If cement or other plugs were used, state the character of same and depth placed, from ----- feet to ----- feet for each plug set.

Stirred Pits. Filled hole with heavy mud to 235'. Set bottom plug w/1/2 hulls 15 sx. cement. Filled hole to 40'. Set top plug w/1/2 sx. hulls 10 sx. cement.

(If additional description is necessary, use BACK of this sheet)


Name of Plugging Contractor Heathman-Seeligson Drilling Co.
Address 1015 E. Second, Wichita, Kansas

STATE OF Kansas, COUNTY OF Sedgwick, ss.
H. D. Shreve (employee of owner) ~~owner or operator~~ of the above-described well, being first duly sworn on oath, says: That I have knowledge of the facts, statements, and matters herein contained and the log of the above-described well as filed and that the same are true and correct. So help me God.

(Signature) By: [Signature]
1015 E. Second, Wichita, Kansas
(Address)

SUBSCRIBED AND SWORN TO before me this 15th day of November, 19 56

Patricia W. Lankin
Patricia W. Lankin
Notary Public.

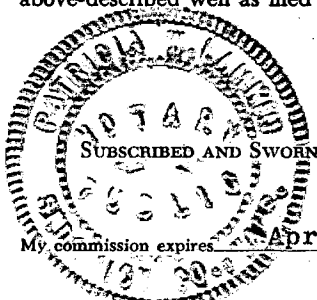

PLUGGING
FILE SEC. 31 T. 8 R. 28W
BOOK PAGE 115 LINE 36

NOV 20 1956

11-20-56

15-179-00177-00-00

DRILLERS' LOG

NAME: CLARK "E" #1 DATE SPUDDED: 10-28-56

LOCATION: Center NW/4 SE/4 Sec.31-8S-28W ROTARY COMPLETED: 11-10-56
 Sheridan County, Kansas

OPERATOR: Heathman-Seeligson Drilling Co. ELEVATION: 2742 GR
 2744 DF
 2747 KB

CONTRACTOR: Heathman-Seeligson Drilling Co. ROTARY TOTAL DEPTH: 4434'

SURFACE CASING: Ran 12 jts. 8-5/8" used csg. cemented at 241.89' w/170 sacks of sack cement and 2 Calcium Chloride. Cement Circulated.

OIL STRING: None run - Dry and abandoned 11-10-56

DRILL STEM TESTS

#1 3818-45 open 1 hr., rec. 20' mud. IFP-0#, FFP-0#, BHP-1070# in 30 min.

#2 3845-70 open 1 hr., rec. 5' mud All pressures 0#.

#3 3868-3905 open 1 hr., rec. 85' salty mud. IFP-0#, FFP-0#, BHP-660# in 30 min.

#4 3920-40 open 1 hr., rec. 2880' muddy slightly gassy saltwater. IFP-790#, FFP-1360, BHP-1360#.

#5 3974-4000 open 45 min., rec. 8' drlg. mud. FFP-0#, BHP-980# in 30 min.

GEOLOGICAL TOPS (KB)

Heebner	3813 (-1066)
Toronto	3836 (-1089)
Lansing K.C.	3852 (-1105)
Base K.C.	4089 (-1342)
Marmaton	4157 (-1410)
Cherokee	4261 (-1514)
Miss. Chert	4382 (-1635)
Miss. Lime	4417 (-1635)
R.T.D.	4434

LOG

(Figures indicate bottom of formation)

Clay & Shale	0 - 70
Sand	200
Shale	525
Shale & Shells	1475
Sand & Shale	1680
Shale, Shells & Sand	1775
Shale & Shells	1878
Blain Anhydrite	1910
Shale & Shells	2365
Anhydrite	2400
Shale & Red Bed	2500
Shale & Lime	3285
Lime	3340
Lime & Shale	3845
Lime	4070
Lime & Shale	4178
Lime	4300
Lime & Shale	4405
Lime, Shale & Chert	4434

The undersigned, H. D. Shreve, hereby certifies that the above log is a true and correct log of the formations encountered in drilling the above noted well as reflected by the Daily Drilling Report.

HEATHMAN-SEELIGSON DRILLING CO.

By: *[Signature]*

Subscribed and sworn to before me the 15th day of November, 1956

Patricia W. Lanekin
Patricia W. Lanekin, Notary Public

My commission expires: April 3, 1960

RECEIVED
STATE CORPORATION COMMISSION

NOV 20 1956

CONSERVATION DIVISION
Wichita, Kansas

11-20-56

PLUGGING

FILE SEC 31 T 8 R 28W

BOOK PAGE 115 LINE 36