


STATE OF KANSAS
STATE CORPORATION COMMISSION

Give All Information Completely
Make Required Affidavit
Mail or Deliver Report to:
Conservation Division
State Corporation Commission
800 Biting Building
Wichita, Kansas

15-179-05129-00-00
WELL PLUGGING RECORD

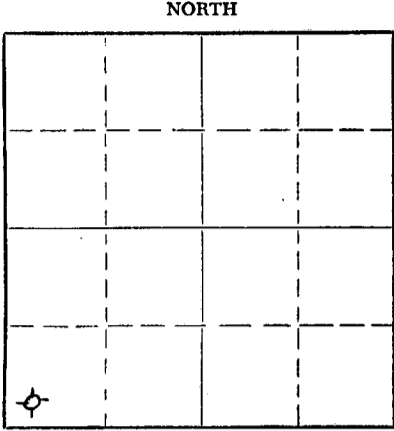

Locate well correctly on above
Section Plat

Sheridan County, Sec. 31 Twp. 8 Rge. 28W (E) (W)

Location as "NE/CNW/SW" or footage from lines SW SW SW
Lease Operator: Hinkle Oil Company
Lease Name Bowen Well No. 1
Office Address 1016 Union Center, Wichita 2, Kansas
Character of Well (completed as Oil, Gas or Dry Hole) Dry Hole
Date well completed 2-21 19 57
Application for plugging filed (verbal) 2-12 19 59
Application for plugging approved (verbal) 2-12 19 59
Plugging commenced 2-16 19 59
Plugging completed 2-20 19 59
Reason for abandonment of well or producing formation Dry Hole

If a producing well is abandoned, date of last production 19
Was permission obtained from the Conservation Division or its agents before plugging was commenced? Yes

Name of Conservation Agent who supervised plugging of this well A. D. Fabricius
Producing formation _____ Depth to top _____ Bottom _____ Total Depth of Well 3961 Feet
Show depth and thickness of all water, oil and gas formations.

OIL, GAS OR WATER RECORDS

CASING RECORD

FORMATION	CONTENT	FROM	TO	SIZE	PUT IN	PULLED OUT
		0	227	8-5/8"	227	None

Describe in detail the manner in which the well was plugged, indicating where the mud fluid was placed and the method or methods used in introducing it into the hole. If cement or other plugs were used, state the character of same and depth placed, from _____ feet to _____ feet for each plug set.

Mudded from 3785' to 277' run 20 sacks cement
from 227' to 160' mudded from 160' to 30' run
10 sacks cement to base of cellar.

RECEIVED
STATE CORPORATION COMMISSION
MAR 11 1959
CONSERVATION DIVISION

3-11-59

(If additional description is necessary, use BACK of this sheet)
Name of Plugging Contractor Glenn & Smith Pipe Pulling Co.
Address Box 114 Ellinwood, Kansas

STATE OF Kansas, COUNTY OF Sedgwick, ss.
J. B. Hinkle, Co-Owner Hinkle Oil Co. (employee/owner) or (owner/operator) of the above-described well, being first duly sworn on oath, says: That I have knowledge of the facts, statements, and matters herein contained and the log of the above-described well as filed and that the same are true and correct. So help me God. Hinkle Oil Company

(Signature) By: J. B. Hinkle
1016 Union Center, Wichita 2, Kansas
(Address)


SUBSCRIBED AND SWORN TO before me this 9 th day of March, 19 59

Mural A. Upston
Notary Public.

My commission expires 17-1962

24-2675-S 2-52-20M

PLUGGING
FILE SEC 31 T 8 R 28W
BOOK PAGE 21 LINE 34

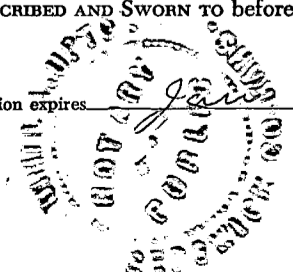

15-179-05129-00-00

W E L L LOG

OPERATOR:	HINKLE OIL COMPANY 1016 Union Center Building Wichita 2, Kansas	FARM NAME:	#1 BOWEN
CONTRACTOR:	K & E DRILLING, INC. 719 Union Center Building Wichita 2, Kansas	LOCATION:	SW SW SW Sec. 31-88-27W Sheridan County, Kansas
CASING RECORD:	8-5/8" @ 227' (175 ex) 4-1/2" @ 3957' (150 ex)	COMMENCED:	2-13-57
R.T.D.	3961'	COMPLETED:	2-21-57
		PRODUCTION:	UNKNOWN
		ELEVATION:	UNKNOWN 2737 K.B.

FORMATION RECORD

Depths shown indicate bottom of formations

Cellar	8
Clay & Sand	70
Sand	95
Shale	760
Sandy Shale	1085
Shale & Shells & Sand	1800
Shale & Shells	2000
Sand & Shale	2160
Red Bed	2170
Red Bed & Shale	2360
Anhydrite	2400
Shale & Shells	2565
Shale & Lime	2650
Shale	2965
Lime & Shale	3360
Lime	3520
Lime & Shale	3875
Lime	3961
R.T.D.	3961

CERTIFICATION

STATE OF KANSAS)
) SS:
COUNTY OF SEDGWICK)

I, Dale Silcott of the K & E DRILLING, INC., upon oath state that the above and foregoing is a true and correct copy of the log of the #1 Bowen well.

Dale Silcott

Dale Silcott

Subscribed and sworn to before me this 26th day of February, 1957.

Patricia M. Edwards

Patricia M. Edwards, Notary Public

My commission expires: 11 August 1958

PLUGGING
FILE SEC. 31 T. 8 R. 28W
BOOK PAGE 21 LINE 34

RECEIVED
STATE CORPORATION COMMISSION
MAR 11 1959
CONSERVATION DIVISION
Wichita, Kansas
3-11-59

INVOICE 15-179-05/29-00-00

Glenn & Smith Pipe Pulling Co.

R. E. Smith
Phone 582-R

Ralph Glenn
Phone 449-R

Box 114
ELLINWOOD, KANSAS

Date 2 / 24 / 59
 Invoice No. 6
 Well No. 1
 Sec. 31 - 8 - 27
 Lease Leven

Sold To: Hinkle Oil Co.

2/16/59	Cleaning out cellar, took braden head apart and rigging up.	9 hrs.	\$ 63.00
2/18/59	Stringing in filled with sand from 3971' to 3810' and run 3 sacks cement from 3810' to 3785', shot at 3280' 3210' and mud came in and up to 1850'	9 hrs.	63.00
2/19/59	Slide to pump out mud, shot at 1850' and started 4 1/2" pipe.	7 hrs.	49.00
2/20/59	Mudded from 3785' to 277' run 20 sacks cement from 227' to 160' mudded from 160' to 30' run 10 sacks cement to base of cellar.	6 hrs.	42.00
	31 hrs. @ \$7.00 per hr.		\$ 217.00
	1864.82' 4 1/2" pipe @ .20 per foot		372.96
	3 shot @ \$10.00 per shot		30.00
			<u>\$ 619.96</u>

Permit No. 396
 State Fuigger: A. D. Fabricius