


STATE OF KANSAS  
STATE CORPORATION COMMISSION

Give All Information Completely  
Make Required Affidavit  
Mail or Deliver Report to:  
Conservation Division  
State Corporation Commission  
211 No. Broadway  
Wichita, Kansas

15-179-00170-00-00  
WELL PLUGGING RECORD

NORTH

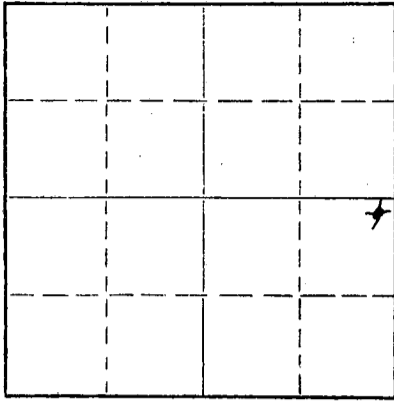

Locate well correctly on above  
Section Plat

Sheridan County, Sec. 32 Twp. 8S Rge. 28 (X) (W)  
Location as "NE/CNW/SW" or footage from lines NE/4 NE/4 SE/4  
Lease Owner Heathman-Seeligson Drilling Co.  
Lease Name CLARK "A" Well No. 1  
Office Address 1015 East Second, Wichita, Kansas  
Character of Well (completed as Oil, Gas or Dry Hole) Dry Hole  
Date well completed 7-30 19 56  
Application for plugging filed 7-30 19 56  
Application for plugging approved 7-30 19 56  
Plugging commenced 7-30 19 56  
Plugging completed 7-30 19 56  
Reason for abandonment of well or producing formation Dry and Abandoned

If a producing well is abandoned, date of last production \_\_\_\_\_ 19\_\_\_\_  
Was permission obtained from the Conservation Division or its agents before plugging was commenced? Yes

Name of Conservation Agent who supervised plugging of this well Eldon Petty, Box 326, Hays, Kansas  
Producing formation \_\_\_\_\_ Depth to top \_\_\_\_\_ Bottom \_\_\_\_\_ Total Depth of Well 1430 Feet  
Show depth and thickness of all water, oil and gas formations.

OIL, GAS OR WATER RECORDS

CASING RECORD

FORMATION	CONTENT	FROM	TO	SIZE	PUT IN	PULLED OUT
				Ran 12 jts. 8 5/8"		
				used surface casing.		
				Cemented w/150 sacks		
				cement, 2 calcium chloride.		
				Cement circulated.		

Describe in detail the manner in which the well was plugged, indicating where the mud fluid was placed and the method or methods used in introducing it into the hole. If cement or other plugs were used, state the character of same and depth placed, from \_\_\_\_\_ feet to \_\_\_\_\_ feet for each plug set.

Plugged hole at 220'  
w/1/2 sack hulls and  
15 sacks cement. Filled  
hole to 40' and set top  
plug w/1/2 sacks hulls  
and 10 sacks cement.

RECEIVED  
STATE CORPORATION COMMISSION  
AUG 14 1956  
8/14/56  
CONSERVATION DIVISION  
Wichita, Kansas

(If additional description is necessary, use BACK of this sheet)  
Name of Plugging Contractor Heathman-Seeligson Drilling Co.  
Address 1015 East Second, Wichita, Kansas

STATE OF KANSAS, COUNTY OF SEDGWICK, ss.  
H. E. Turner (employee of owner) or (~~owner or operator~~) of the above-described well, being first duly sworn on oath, says: That I have knowledge of the facts, statements, and matters herein contained and the log of the above-described well as filed and that the same are true and correct. So help me God.

(Signature) H. E. Turner  
1015 East Second, Wichita, Kansas  
(Address)

Subscribed and Sworn to before me this 3rd day of August, 1956  
My commission expires April 3, 1960  
Patricia J. Lanier  
Notary Public.



PLUGGING  
FILE SEC. 32 T. 8 R. 28W  
BOOK PAGE 85 LINE 39

15-179-00170-0000

DRILLERS' LOG

NAME: CLARK "A" #1 DATE SPUDDED: 7-16-56  
 LOCATION: NE/4 NE/4 SE/4 Sec. 32-8S-28W ROTARY COMPLETED: 7-30-56  
 Sheridan County, Kansas  
 OPERATOR: Heathman-Seeligson Drilling Co. ELEVATION: 2732 GR  
 2734 DF  
 2737 KB  
 CONTRACTOR: Heathman-Seeligson Drilling Co. ROTARY TOTAL DEPTH: 4430'  
 SURFACE CASING: Ran 12 jts. 8 5/8" used surface casing. Cemented w/150 sacks cement, 2 c.c. Cement circulated.  
 OIL STRING: None run - Dry and abandoned 7-30-56

GEOLOGICAL TOPS (KB)

Anhydrite	2373 (+ 364)
Heebner	3821 (-1084)
Toronto	3844 (-1107)
Lansing	3860 (-1123)
Base Kansas City	4100 (-1363)
Marmaton	4170 (-1433)
Cherokee	4280 (-1543)
Mississippian	4415 (-1678)
R. T. D.	4430

L O G

(Figures indicate bottom of formation)

Clay and sand	0 - 40
Shale	70
Sand	242
Shale and shells	1490
Sand	1700
Shale and shells	1850
Sand	1930
Sandy shale	2030
Shale and red beds	2250
Shale and shell	2373
Anhydrite	2410
Shale and shells	2955
Shale and lime	3175
Hard sandy lime	3290
Lime and shale	3310
Shale and lime	3622
Lime and shale	3800
Shale and lime	3878
Lime	4145
Lime and shale	4195
Shale and lime	4320
Lime and shale	4430

The undersigned, H. E. Turner, hereby certifies that the above log is a true and correct log of the formations encountered in drilling the above noted well as reflected by the Daily Drilling Report.

HEATHMAN-SEELIGSON DRILLING CO.

By: *H. E. Turner*

STATE COMMISSION  
 AUG 14 1956  
 CONSTRUCTION DIVISION

Subscribed and sworn to before me the 3rd day of August, 1956.  
*Patricia A. Lambert*  
 Notary Public

My commission expires: April 3, 1960

**PLUGGING**  
 FILE SEC 32 T 8 R 29W  
 BOOK PAGE 85 LINE 39