

STATE OF KANSAS
STATE CORPORATION COMMISSION

15-179-20534-00-00

WELL PLUGGING RECORD

Give All Information Completely
Make Required Affidavit
Mail or Deliver Report to
Conservation Division
State Corporation Comm.
245 North Water
Wichita, KS 67202

Sheridan County, Sec. 33 Twp. 8S Rge. 28WE/W
Location as "NE/CNW $\frac{1}{4}$ SW $\frac{1}{4}$ " or footage from lines
200' S of E/2 E/2 SW/4

Lease Owner Abercrombie Drilling, Inc.
Lease Name Shaw Well No. 1

Office Address 801 Union Center, Wichita, Kansas 67202
Character of Well (Completed as Oil, Gas or Dry Hole)


Dry Hole

Date Well completed May 5 19 79
Application for plugging filed (verbally) May 5 19 79
Application for plugging approved (verbally) May 5 19 79
Plugging commenced May 5 19 79
Plugging completed May 5 19 79

Reason for abandonment of well or producing formation
No commercial quantity of oil or gas encountered.
If a producing well is abandoned, date of last production 19

Was permission obtained from the Conservation Division or its agents before plugging was commenced? Yes

Name of Conservation Agent who supervised plugging of this well Gilbert Balthazor
Producing formation _____ Depth to top _____ Bottom _____ Total Depth of Well 4090'
Show depth and thickness of all water, oil and gas formations.

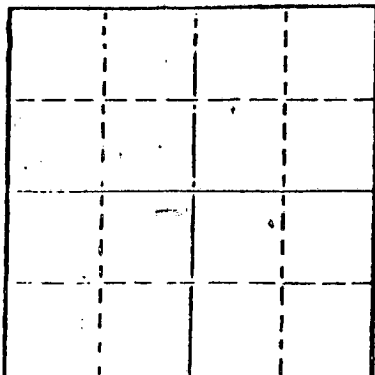

Locate well correctly on above Section Plat

OIL, GAS OR WATER RECORDS

CASING RECORD

FORMATION	CONTENT	FROM	TO	SIZE	PUT IN	PULLED OUT

Describe in detail the manner in which the well was plugged, indicating where the mud fluid was placed and the method or methods used in introducing it into the hold. If cement or other plugs were used, state the character of same and depth placed, from _____ feet to _____ feet for each plug set.

T.D. 4090'

Set 1st plug at 1300' with 70 sacks

2nd plug at 240' with 20 sacks

3rd plug at 40' solid bridge with 10 sacks

rathole with 5 sacks

Cemented with 50/50 posmix, 6% gel.

Plug was down at 5:30 p.m., May 5, 1979.

RECEIVED
STATE CORPORATION COMMISSION

(If additional description is necessary, use BACK of this sheet)

Name of Plugging Contractor Abercrombie Drilling, Inc. CONSERVATION DIVISION
Wichita, Kansas

5-17-79

STATE OF Kansas COUNTY OF Sedgwick, ss.
Jack L. Partridge, Asst. Sec.-Treas. (employee of owner) or (owner or operator)
of the above-described well, being first duly sworn on oath, says: That I have knowledge of the facts, statements, and matters herein contained and the log of the above-described well as filed and that the same are true and correct. So help me God;

(Signature) Jack L. Partridge
801 Union Center, Wichita, Kansas 67202
(Address)

SUBSCRIBED AND SWORN TO before me this 15th day of May, 1979



Sherrie L. Brooks
Notary Public.

My commission expires 8-21-82