

STATE OF KANSAS
STATE CORPORATION COMMISSION

WELL PLUGGING RECORD

Give All Information Completely
Make Required Affidavit
Mail or Deliver Report to:
Conservation Division
State Corporation Commission
211 No. Broadway
Wichita, Kansas

Sheridan County, Sec. 27 Twp. 8S Rge. 26W (E) (W)

Location as "NE/CNW&SW&" or footage from lines C NW SE

Lease Owner Imperial Oil of Kansas, Inc.

Lease Name Pratt Estate Well No. 1

Office Address 780 Fourth National Bldg., Wichita 2, Kansas

Character of Well (completed as Oil, Gas or Dry Hole) Oil Well

Date well completed March 29 19 59

Application for plugging filed April 8 19 60

Application for plugging approved April 14 19 60


Plugging commenced April 18 19 60

Plugging completed April 22 19 60

Reason for abandonment of well or producing formation Commercial quantities of oil depleted.

If a producing well is abandoned, date of last production April 18 19 60

Was permission obtained from the Conservation Division or its agents before plugging was commenced? Yes

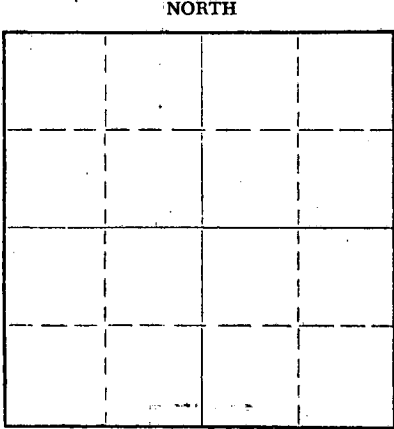

Locate well correctly on above Section Plat

Name of Conservation Agent who supervised plugging of this well Mr. A. D. Fabricius

Producing formation _____ Depth to top _____ Bottom _____ Total Depth of Well 3970 Feet

Show depth and thickness of all water, oil and gas formations.

OIL, GAS OR WATER RECORDS

CASING RECORD

FORMATION	CONTENT	FROM	TO	SIZE	PUT IN	PULLED OUT
				8-5/8	225'	Not pulled
				5-1/2	3970'	

RECEIVED
STATE CORPORATION COMMISSION
MAY 20 1960
5-20-1960
CONSERVATION DIVISION
Wichita, Kansas

Describe in detail the manner in which the well was plugged, indicating where the mud fluid was placed and the method or methods used in introducing it into the hole. If cement or other plugs were used, state the character of same and depth placed, from _____ feet to _____ feet for each plug set.

Sanded hole back from 2921' to 3780' mixed and run 3 sacks cement with dump bailer. Took tension on pipe, Removed cellar slips had 11" tension on pipe at 94,000 lbs. Loaded hole with water, worked pipe to 17" tension. Worked pipe, shot casing at 300' 2690' 2500' 2268' worked as much as 19" tension could not work free. Shot casing at 2000' 1904' 1804' loose at 1804' pulled total string of 55 jts. Mudded hole to 225' set 10" rock bridge with 25 sacks cement mudded hole to 40' set 10' rock bridge with 10 sacks cement to base of cellar. ~~XXXXXX~~

(If additional description is necessary, use BACK of this sheet)
Name of Plugging Contractor Southwest Casing Pulling Co., Inc.
Address P. O. Box 364 Great Bend, Kansas

STATE OF KANSAS, COUNTY OF SEDGWICK, ss.
K. J. Boone (employee of ~~owner~~ or operator) of the above-described well, being first duly sworn on oath, says: That I have knowledge of the facts, statements, and matters herein contained and the log of the above-described well as filed and that the same are true and correct. So help me God. IMPERIAL OIL OF KANSAS, INC.

(Signature) BY: K. J. Boone Pet. Engr.
780 Fourth National Bldg., Wichita 2, Kansas
(Address)

Subscribed and sworn to before me this 19th day of May, 19 60
My commission expires July 7, 1962



Maria L. Labe
Notary Public.

DRILLER'S LOG

Imperial Oil of Kansas, Inc.
780 Fourth National Building
Wichita 2, Kansas

Pratt Estate No. 1
C NW SE Sec. 27-8S-26W
Sheridan County, Kansas

Total Depth: 3970'

Elevation: 2572' RB
Production: State Potential:
P 30 BOPD / 50% Wtr.
Grav. 27°

Commenced: 3-16-59 Completed: 3-29-59

Contractor: Imperial Oil of Kansas, Inc.
Wichita 2, Kansas

Casing Record: 8-5/8" Surface Pipe at 225' with 175 sacks cement.
5-1/2" Production Pipe at 3970' with 125 sacks cement.

Figures indicate bottom of formations:

Surface Sand & Clay	225'
Shale-Shells & Sand	1000'
Shale & Shells	1505'
Dakota Sand	1655'
Shells & Shale	1780'
Dakota Sand	1980'
(Red Bed) Shale	2130'
Shale	2200'
Anhydrite	2235'
Shale & Shells	2545'
Shale & Lime	3530'
Lime	3600'
Shale & Lime	3666'
Lime	3970'
Total Depth	3970'

TOPS

Heebner	3706'	{ -1134 }
Toronto	3730'	{ -1158 }
Lansing	3742'	{ -1170 }
Rotary Total Depth	3970'	{ -1398 }

RECEIVED
STATE CORPORATION COMMISSION

MAY 20 1960
5-20-1960
CONSERVATION DIVISION
Wichita, Kansas

We hereby certify this to be a correct and accurate log of the above described well as shown on the daily drilling reports.

IMPERIAL OIL OF KANSAS, INC.

By: A. L. Bacon
Vice-President

Subscribed and sworn to before me this 7th day of April, 1959.

My Commission Expires:

July 7, 1962

Mona L. Latier
Mona L. Latier - Notary Public

