


STATE OF KANSAS
STATE CORPORATION COMMISSION

WELL PLUGGING RECORD

Give All Information Completely
Make Required Affidavit
Mail or Deliver Report to:
Conservation Division
State Corporation Commission
212 No. Market
Wichita, Kansas

NORTH

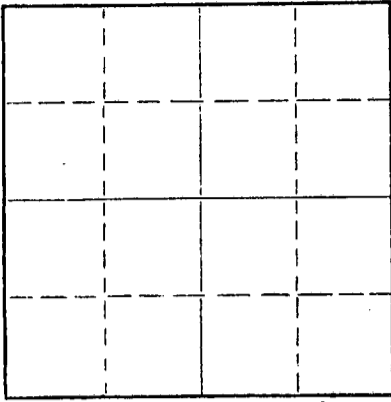

Locate well correctly on above
Section Plat

Sheridan County. Sec. 10 Twp. 8 Rge. 27 (E)W (W)
Location as "NE/CNW/SW" or footage from lines: NW-SE
Lease Owner: Leo J. Dreiling Oil Company
Lease Name: McClelland Well No. 1
Office Address: Route 2, Victoria, Kansas 67671
Character of Well (completed as Oil, Gas or Dry Hole): Dry Hole
Date well completed: 10-19 67
Application for plugging filed: 10-10 19 67
Application for plugging approved: 10-10 19 67
Plugging commenced: 10-10 19 67
Plugging completed: 10-10 19 67
Reason for abandonment of well or producing formation: Dry Hole

If a producing well is abandoned, date of last production: 19____
Was permission obtained from the Conservation Division or its agents before plugging was commenced? Yes

Name of Conservation Agent who supervised plugging of this well: W. L. Nickols
Producing formation: _____ Depth to top: _____ Bottom: _____ Total Depth of Well: _____ Feet
Show depth and thickness of all water, oil and gas formations.


OIL, GAS OR WATER RECORDS

CASING RECORD

FORMATION	CONTENT	FROM	TO	SIZE	PUT IN	PULLED OUT
Surface Pipe				8 5/8"	214'	

Describe in detail the manner in which the well was plugged, indicating where the mud fluid was placed and the method or methods used in introducing it into the hole. If cement or other plugs were used, state the character of same and depth placed, from _____ feet to _____ feet for each plug set.

1st. plug was set at 2105' with 70 sacks cement
2nd. plug was set at 214' with 20 sacks cement
3rd. plug was set at 40' with 10 sacks cement
and filling hole to bottom of cellar

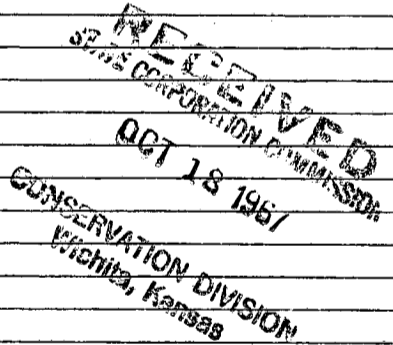

10-18-67


(If additional description is necessary, use BACK of this sheet)

Name of Plugging Contractor: L. J. Dreiling & Sons, Inc.
Address: Route 2, Victoria, Kansas 67671

STATE OF KANSAS, COUNTY OF ELLIS, ss.
I, Leo F. Dreiling (employee of owner) or (owner/contractor) of the above-described well, being first duly sworn on oath, says: That I have knowledge of the facts, statements, and matters herein contained and the log of the above-described well as filed and that the same are true and correct. So help me God.

(Signature) Leo Dreiling
LEO F. DREILING, ROUTE 2, VICTORIA, KANSAS 67671
(Address)

SUBSCRIBED AND SWORN TO before me this 16th day of October, 19 67

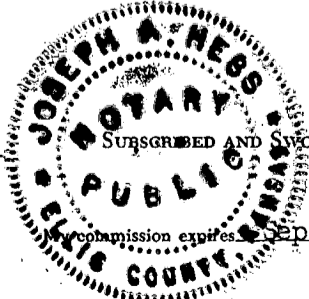

Joseph A. Hess
JOSEPH A. HESS
Notary Public.

15-179-20047-00-00

L. J. DREILING and SONS, Inc.
VICTORIA, KANSAS

WELL LOG

Company	Leo J. Dreiling Oil Company Route 2 Victoria, Kansas 67671	Sec. 10	Twp. 8	Rng. 27
Farm	McClelland No. 1	Location	NW-SE	
Total Depth	4060'	County	Sheridan	
Comm.	10-6-67	Comp.	10-10-67	
Contractor	L. J. Dreiling & Sons, Inc. Victoria, Kansas 67671	Elevation:	2627'	K.B.
			2624'	D. F.
			2622'	G. R.
	Casing Record	Cement Record	Production: D & A	
	214' - 8 5/8"	150 sacks cement		

Figures Indicate Bottom of Formations

0'	104'	Surface Clay & Sand
104'	190'	Sand & Clay
190'	214'	Shale
214'	1390'	Shale
1390'	1930'	Shale & Gyp & Sand Streaks
1930'	2070'	Sand
2070'	2095'	Sand
2095'	2300'	Shale
2300'	2336'	Anhy.
2336'	2540'	Shale & Shells
2540'	2910'	Shale
2910'	3150'	Shale & Lime
3150'	3300'	Shale & Lime
3300'	3550'	Shale & Lime
3550'	3667'	Lime
3667'	3862'	Lime
3862'	3935'	Lime
3935'	4043'	Lime
4043'	4060'	Lime
4060'	T.D.	

REGISTRATION DIVISION
 ACT 18 1967
 10-12-67

STATE OF KANSAS)
)ss
COUNTY OF ELLIS)

I, Leo F. Dreiling, of the L. J. Dreiling & Sons, Inc., upon oath states that the above and foregoing is a true and correct copy from the Daily Drilling Report from your McClelland #1.

Leo F. Dreiling
LEO F. DREILING

Subscribed and sworn to before me this 10th day of October 1967.

Joseph A. Hess
JOSEPH A. HESS NOTARY PUBLIC



My commission expires: September 19, 1970