

[Handwritten mark]


STATE OF KANSAS
STATE CORPORATION COMMISSION

Give All Information Completely
Make Required Affidavit
Mail or Deliver Report to:
Conservation Division
State Corporation Commission
211 No. Broadway
Wichita, Kansas

WELL PLUGGING RECORD

Sedgwick County. Sec. 12 Twp. 26 Rge. 2 (E) 11/11

Location as "NE/CNW%SW%" or footage from lines NE NW SW
Lease Owner Murfin Drilling Company
Lease Name Lygrisse Well No. 2
Office Address 617 Union Center, Wichita, Kansas
Character of Well (completed as Oil, Gas or Dry Hole) oil
Date well completed 9-27 19 57
Application for plugging filed 7-07 19 62
Application for plugging approved 7-08 19 62
Plugging commenced 7-19 19 62
Plugging completed 7-25 19 62
Reason for abandonment of well or producing formation low production

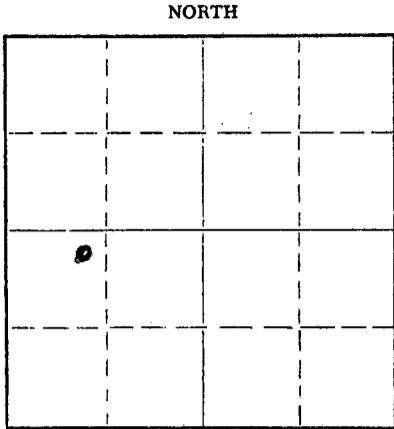

Locate well correctly on above Section Plat

If a producing well is abandoned, date of last production 7-16- 19 62
Was permission obtained from the Conservation Division or its agents before plugging was commenced? yes

Name of Conservation Agent who supervised plugging of this well Howard Hess
Producing formation _____ Depth to top _____ Bottom _____ Total Depth of Well 2858 Feet
Show depth and thickness of all water, oil and gas formations.

OIL, GAS OR WATER RECORDS

CASING RECORD

FORMATION	CONTENT	FROM	TO	SIZE	PUT IN	PULLED OUT
				8 5/8	200	none
				4 1/2	2852	458.

Describe in detail the manner in which the well was plugged, indicating where the mud fluid was placed and the method or methods used in introducing it into the hole. If cement or other plugs were used, state the character of same and depth placed, from _____ feet to _____ feet for each plug set.

Hole filled with rock to 2850 feet.
Dumped 5 sacks cement.
Set 20 foot rock bridge 205 to 225 feet.
Dumped 15 sacks cement on bridge
Hole filled with mud to 30 feet.
Set 5 foot rock bridge 25 to 30 feet.
Dumped 8 sacks cement.

RECEIVED
STATE CORPORATION COMMISSION
AUG 1 1962
8-1-62
CONSERVATION DIVISION
Wichita, Kansas

(If additional description is necessary, use BACK of this sheet)

Name of Plugging Contractor Kent Well Servicing Co., Inc.
Address Box 470, El Dorado, Kansas

STATE OF Kansas, COUNTY OF Butler, ss.

_____, (employee of owner) or (owner or operator) of the above-described well, being first duly sworn on oath, says: That I have knowledge of the facts, statements, and matters herein contained and the log of the above-described well as filed and that the same are true and correct. So help me God.

(Signature) Mary Payne

(Address) _____

SUBSCRIBED AND SWORN to before me this 13th day of August, 19 62

Sam R. Daniel
Notary Public.

My commission expires April 14, 1966




Company- HUCICENDAH & GOULD
Farm- Lygrisse No. 2

SEC. 12. T. 26 R. 2E
NE NW SW

Total Depth. 2858'
Comm. 8-30-57 Comp. 9-27-57
Shot or Treated.
Contractor. Winne Oil Co.
Issued. 3-18-61

County Sedgwick
KANSAS

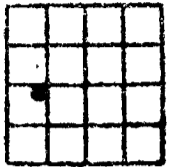

CASING:

8" 200'
4" 2852'

Elevation. 1356' RB

Production. 20 BOPD

Figures Indicate Bottom of Formations.

RECEIVED
STATE CORPORATION COMMISSION

AUG 14 1961

REGULATORY DIVISION
Topeka, Kansas

COMPLETE DRILLERS LOG NOT AVAILABLE.

TOPS: SCOUT
Kansas City 2375
B/Kansas City 2540
Conglomerate 2806
Mississippi 2814
Mississippi lime 2825
Mississippi chat 2854