



STATE OF KANSAS
STATE CORPORATION COMMISSION

Give All Information Completely
Make Required Affidavit
Mail or Deliver Report to:
Conservation Division
State Corporation Commission
211 No. Broadway
Wichita, Kansas

WELL PLUGGING RECORD

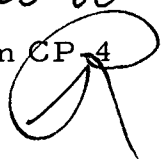

NORTH

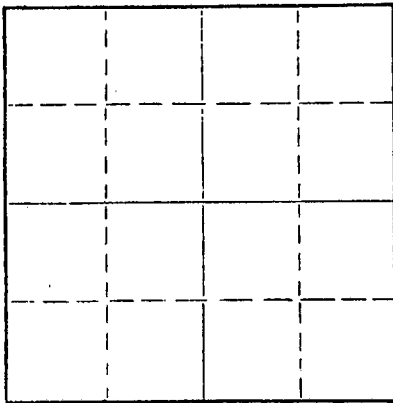

Locate well correctly on above
Section Plat

Sedgwick County. Sec. 12 Twp. 26 Rge. 2E (E) (W//)
Location as "NE/CNWSW" or footage from lines SW SW NW
Lease Owner Warren R. Winnie
Lease Name I. S. DeMoss Well No. 2-A
Office Address 5503 E. Kellogg - Wichita, Kansas
Character of Well (completed as Oil, Gas or Dry Hole) D&A
Date well completed 5/13/60 19
Application for plugging filed 5/13/60 19
Application for plugging approved 5/13/60 19
Plugging commenced 5/13/60 19
Plugging completed 5/13/60 19
Reason for abandonment of well or producing formation

If a producing well is abandoned, date of last production 19
Was permission obtained from the Conservation Division or its agents before plugging was commenced? Yes

Name of Conservation Agent who supervised plugging of this well Lee Guthrie
Producing formation _____ Depth to top _____ Bottom _____ Total Depth of Well 2906' Feet
Show depth and thickness of all water, oil and gas formations.

OIL, GAS OR WATER RECORDS

CASING RECORD

FORMATION'	CONTENT	FROM	TO	SIZE	PUT IN	PULLED OUT

Describe in detail the manner in which the well was plugged, indicating where the mud fluid was placed and the method or methods used in introducing it into the hole. If cement or other plugs were used, state the character of same and depth placed, from _____ feet to _____ feet for each plug set.

2905' 5 1/2" Pipe set with 100 sacks cement.
Top perforation at 2826'. Hole filled with sand to 2800' and 5 sacks cement at 200' set 20' Rock Bridge and 20 sacks cement - Mud to 35' set 5'. Rock bridge 10 sacks cement which filled hole to plow surface
Recovered 2286' - 5 1/2" pipe.

RECEIVED
STATE CORPORATION COMMISSION
9-17-63
SEP 17 1963

CONSERVATION DIVISION
Wichita, Kansas

(If additional description is necessary, use BACK of this sheet)

Name of Plugging Contractor Art Lamb casing pulling company
Address Box 983, Hutchinson, Kansas

STATE OF Kansas COUNTY OF Sedgwick, ss.
(employee of owner) or (owner or operator) of the above-described well, being first duly sworn on oath, says: That I have knowledge of the facts, statements, and matters herein contained and the log of the above-described well as filed and that the same are true and correct. So help me God.

(Signature)

Warren R. Winnie
5503 E. Kellogg
(Address)

SUBSCRIBED AND SWORN to before me this 13 day of September, 1963

Margaret Davis
Notary Public.





Warren R. Winne

OIL PRODUCER

511 Union National Building,
Wichita 1, Kansas

STANDARD OIL COMPANY
COMMISSION

MAY 2 1960

CONSERVATION DIVISION
Wichita, Kansas

Drillers Log

Company: Warren R. Winne
511 Union National Bldg.
Wichita 2, Kansas

SW SW NW
12-26S-2E
Sedgwick

Farm: I.S. DeMoss

Elev: 1337 RB

Red Drig. Co.

Well No. 2 "A"

Pipe Record:

8-5/8"	130'	with 125 sax
5-1/2"	2905'	with 100 sax

soil	75	
lime	245	
shale	1518	
lime	1607	
shale	2098	
lime	2519	
cherty lime	2797	
conglomerate	2820	
Mississippi	2866	
Chert	2878	
chert and lime	2906	RTD

Perforations from

2826 to 2836

also

2866 to 2875