

15-173-03628-00-00

SP

STATE OF KANSAS
STATE CORPORATION COMMISSION


OCT 3 1967

Form CP-4

WELL PLUGGING RECORD

Give All Information Completely
Make Required Affidavit
Mail or Deliver Report to:
Conservation Division
State Corporation Commission
212 No. Market
Wichita, Kansas

NORTH

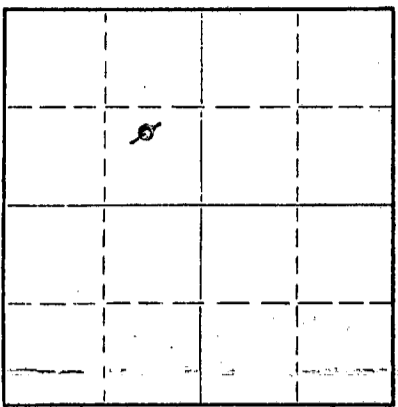

Locate well correctly on above
Section Plat

Sedgwick County, Sec. 12 Twp. 26 Rge. 2 E (E) (W)
Location as "NE/CNW%SW%" or footage from lines N/2 SE/4 NW/4 (1600' FNL 1815' FWL)
Lease Owner Clinton Oil Company
Lease Name DeMoss B ANS KCC Well No. 2-2
Office Address 6810 West Highway US 54 Wichita, Kansas
Character of Well (completed as Oil, Gas or Dry Hole) Oil
Date well completed September 7 19 58
Application for plugging filed September 5 19 67
Application for plugging approved September 5 19 67
Plugging commenced 9-12-67 19
Plugging completed 9-18-67 19
Reason for abandonment of well or producing formation Depleted

If a producing well is abandoned, date of last production September 9 19 67
Was permission obtained from the Conservation Division or its agents before plugging was commenced? Yes

Name of Conservation Agent who supervised plugging of this well H. Scott ~~James Scott~~ 9842
Producing formation Mississippi Depth to top 2830' Bottom 2837 Total Depth of Well 2837 Feet
Show depth and thickness of all water, oil and gas formations.

OIL, GAS OR WATER RECORDS

CASING RECORD

FORMATION	CONTENT	FROM	TO	SIZE	PUT IN	PULLED OUT
				8 5/8	169	None
				5 1/2	None	24.15

Describe in detail the manner in which the well was plugged, indicating where the mud fluid was placed and the method or methods used in introducing it into the hole. If cement or other plugs were used, state the character of same and depth placed, from _____ feet to _____ feet for each plug set.

Moved in. Cleaned out cellar.

Sanded to 2800'. Dumped 5 sacks of cement. Working pipe. Shot pipe at 2500' and 2405'. Pulling pipe.

Plugging well. Bailed to 180' rock bridge. Dumped 25 sacks of cement. Filled hole and rock bridge. Capped well with 10 sacks of cement.


RECEIVED
STATE CORPORATION COMMISSION
OCT 5 1967
CONSERVATION DIVISION
WICHITA, KANSAS
RECEIVED
STATE CORPORATION COMMISSION
SEP 26 1967
9-26-67
CONSERVATION DIVISION
WICHITA, KANSAS

(If additional description is necessary, use BACK of this sheet)

Name of Plugging Contractor Forbes Casing Pulling, Inc.
Address P. O. Box 221 Great Bend, Kansas

STATE OF Kansas, COUNTY OF Barton, ss.
J. O. Forbes (employee of owner) or (owner or operator) of the above-described well, being first duly sworn on oath, says: That I have knowledge of the facts, statements, and matters herein contained and the log of the above-described well as filed and that the same are true and correct. So help me God.

(Signature) J. O. Forbes
P. O. Box 221 Great Bend, Kansas
(Address)

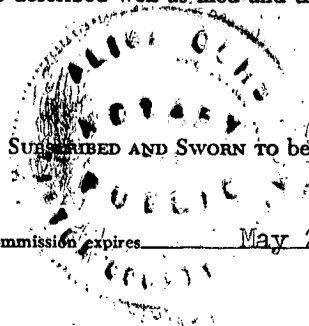

SUBSCRIBED AND SWORN TO before me this 22 day of September, 1967

My commission expires May 27, 1969

Notary Public.

OP

Francis M. Raymond & Warren Winne
#2 DeMoss "B"
1815' EWL & 330' SNL N/2 S/2 NW/4
(approx. C N/2 SE NW/4), 12-26S-2E
Sedgwick County, Kansas

Contractor: Raymond Oil Co., Inc.
Elevation: 1346 KB

Commenced: 9/1/58
Completed: 9/8/58 (Rotary)

Casing Record
8-5/8" @ 169' w/150 sacks
5-1/2 @ 2832' w/50 sacks


Figures Indicate Bottom of formation

<u>Formation</u>	<u>Depth</u>
Clay	12
Shale & Lime	149
Cement	169
Lime & Shale	600
Shale & Shells	1495
Lime & Shale	1518
Shale & Lime	2145
Lime	2212
Shale & Lime	2276
Shale & Lime	2380
Lime	2519
Shale & Lime	2782
Chert	2798
Shale & Lime	2830
Chert	2837
Tops:	
Lansing	2141
Kansas City	2350
Base of Kansas City	2512
Conglomerate Chert Zone	2782
Mississippi	2798
Mississippi Chat	2830
"Pay Zone"	2834
Rotary Total Depth	2837


RECEIVED
STATE CORPORATION COMMISSION
SEP 5 1967
CONSERVATION DIVISION
Wichita, Kansas

STATE OF KANSAS)
) SS
COUNTY OF SEDGWICK)

I hereby certify that the above information is true and correct to the best of my knowledge.


Lloyd M. Greenstreet

Subscribed and sworn to before me this 10th day of September, 1958.

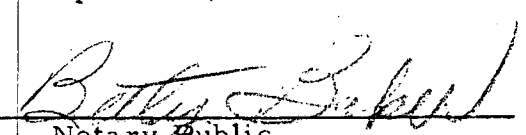
Notary Public

My Commission Expires:
2/24, 60