


STATE OF KANSAS
STATE CORPORATION COMMISSION
200 Colorado Derby Bldg.
Wichita, Kansas 67202

Form CP-4
Rev. 12-15-80

WELL PLUGGING RECORD

Give All Information Completely
Make Required Affidavit

COUNTY Sedgewick SEC. 12 TWP. 26 RGE. 28 EA
Location as in quarters or footage from lines:
3W NE 3W

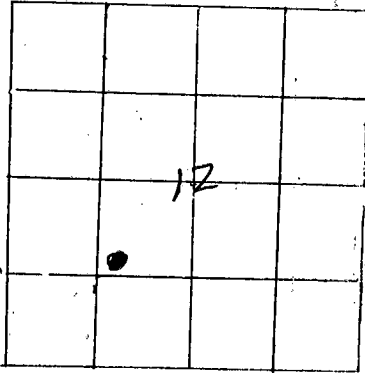

Locate Well
correctly on above
Section Platt.

Lease Owner Bear Pt
Lease Name Lygrissc Well No. 1A
Office Address Box 107 Haysville KS 67060
Character of Well (Completed as Oil, Gas or Dry Hole): Oil
Date Well Completed 7-6-82
Application for plugging filed 9-9-85
Plugging commenced 9-10-85
Plugging completed 9-12-85
Reason for abandonment of well or producing formation

Oil Depleted
Was permission obtained from the Conservation Division or it's
Agent's before plugging was commenced? YES

Name of Conservation Agent who supervised plugging of this well Don Thompson
Producing formation Miss Depth to top 2720 bottom 2950 T.D. 2950
Show depth and thickness of all water, oil and gas formations. 2836

OIL, GAS OR WATER RECORDS

Casing Record

Formation	Content	From	To	Size	Put in	Pulled Out
		0	200	8 3/4	200	NONE
		0	2950	4 1/2	2950	1230

Describe in detail the manner in which the well was plugged, indicating where the mud fluid was placed and the method or methods used in introducing it into the hold. If cement or other plugs were used, state the character of same and depth placed, from _____ feet to _____ feet for each plug set.

Plugged back w/sand to 2775 Dumped 4 sack cement w/ dump bucket 30' of pipe @ 2100 - 1230' pulled pipe.


Plugged top from 275 to 250' w/ oak wood filled to top w/ redi-mix

(If additional description is necessary, use BACK of this sheet)
Name of Plugging Contractor F D Gressel Cross Oil Field Serv
Box 226 Burrton KS 67020

STATE OF Kansas COUNTY OF Harvey, ss.
F D Gressel (employee of owner) or (owner or operator) of the
above-described well, being first duly sworn on oath, says: That I have knowledge of the
facts, statements, and matters herein contained and the log of the above-described well as
filed and that the same are true and correct. So help me God.

(Signature) F D Gressel
Box 226 Burrton KS 67020
(Address)

SUBSCRIBED AND SWORN TO before me this 13th day of September, 19 85

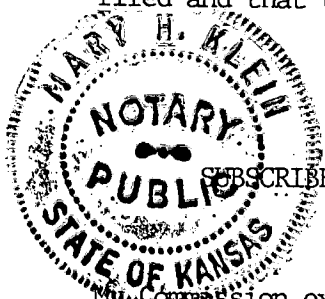

Mary H. Klein
Notary Public.

My Commission expires: March 15, 1989

RECEIVED
STATE CORPORATION COMMISSION

SEP 16 1985
9-16-85
CONSERVATION DIVISION
Wichita, Kansas