

15-163-00802-00-00


WELL PLUGGING RECORD

Give All Information Completely
Make Required Affidavit
Mail or Deliver Report to:
Conservation Division
State Corporation Commission
212 North Market, Insurance Bldg.
Wichita, Kansas

Rooks County, Sec. 31 Twp. 9 Rge. 20 (E) (W)

Location as "NE/CNW/SW" or footage from lines S/2 SW/4 NE/4
Lease Owner Herman Geo. Kaiser, Oil Producer
Lease Name Renner "A" Well No. 1
Office Address 909 Palace Building, Tulsa, Oklahoma
Character of Well (completed as Oil, Gas or Dry Hole) dry
Date well completed January 3, 1960
Application for plugging filed January 3, 1960
Application for plugging approved January 3, 1960
Plugging commenced January 3, 1960
Plugging completed January 3, 1960
Reason for abandonment of well or producing formation dry

NORTH

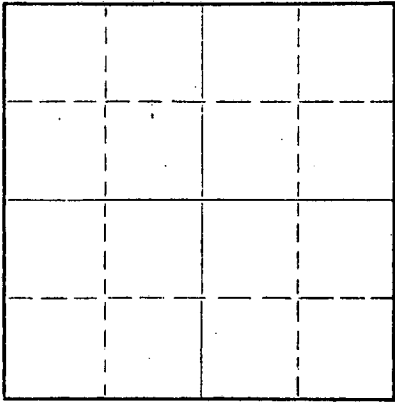

Locate well correctly on above
Section Plat

If a producing well is abandoned, date of last production 19
Was permission obtained from the Conservation Division or its agents before plugging was commenced? yes

Name of Conservation Agent who supervised plugging of this well Eldon Petty
Producing formation _____ Depth to top _____ Bottom _____ Total Depth of Well 3543 Feet
Show depth and thickness of all water, oil and gas formations.

OIL, GAS OR WATER RECORDS

CASING RECORD

FORMATION	CONTENT	FROM	TO	SIZE	PUT IN	PULLED OUT
				8 5/8	205	none

Describe in detail the manner in which the well was plugged, indicating where the mud fluid was placed and the method or methods used in introducing it into the hole. If cement or other plugs were used, state the character of same and depth placed, from _____ feet to _____ feet for each plug set.

FILLED HOLE WITH HEAVY ROTARY MUD TO 600',
SET PLUG AND CEMENTED WITH 20 SACKS CEMENT THROUGH DRILL PIPE.
MUD HOLE TO 200 FT. SET PLUG AND CEMENT WITH 15 SACKS.
MUD TO 40 FT., SET PLUG AND CEMENT WITH 10 SACKS CEMENT
AND 1/2 SACK HULLS.

RECEIVED
STATE CORPORATION COMMISSION

JAN 13 1960
01-13-1960
CONSERVATION DIVISION
Wichita, Kansas

(If additional description is necessary, use BACK of this sheet)

Name of Plugging Contractor H-30, Inc.
Address 709 Petroleum Bldg. Wichita, Kansas

STATE OF Kansas, COUNTY OF Sedgwick
L. C. Sponenberg (employee of contractor) of the above-described well, being first duly sworn on oath, says: That I have knowledge of the facts, statements, and matters herein contained and the log of the above-described well as filed and that the same are true and correct. So help me God.

(Signature) L. C. Sponenberg

(Address) January 11, 1960

Subscribed and sworn to before me this 11 day of January, 1960

My commission expires February 13, 1960

Rose Furey Notary Public.



15-143-00802-00-00

KANSAS GEOLOGICAL SOCIETY
KANSAS WELL LOG BUREAU - KANSAS WELL SAMPLE BUREAU
KANSAS GEOLOGICAL SOCIETY BUILDING
508 EAST MURDOCK - WICHITA, KANSAS

COMPANY **Herman Geo. Kaiser, Oil Producer**


SEC. 31 T. 9 R. 20
LOC. S/2 SW/4 NE/4

FARM **Renner A** NO. **1**

TOTAL DEPTH **3543**
COMM. **12/27/59** COMP. **1/3/60**
SHOT OR TREATED **-**
CONTRACTOR **H-30, Inc.**
ISSUED

COUNTY **Rooks**

KANSAS

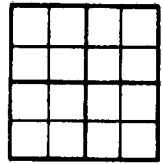

CASING
20 10
15 8 205'
12 6
13 5

ELEVATION **2278 K. B.**

PRODUCTION **D & A**

FIGURES INDICATE BOTTOM OF FORMATIONS

Top soil	10'
Clay-shale-sand	120'
Shale	214'
Shale & shells	600'
Shale-shells with sand streaks	1450'
Shale & shells	1766'
Anhydrite	1805'
Shale-shells & red bed	2120'
Shale-Shells	2270'
Shale with lime streaks	2350'
Lime & shale	3543'

Formation Tops:

Heebner 3537 -1259
T. D. 3543 -1265

I hereby certify that this is a true and correct log of the above described well as shown by the drilling reports.

H-30, INC.

By *L. C. Spozenberg*
L. C. Spozenberg

STATE OF KANSAS)
) ss.
COUNTY OF SEDGWICK)

Subscribed and sworn to before me, a Notary Public, in and for said County and State this 12th day of January, 1960.

Rose Furey
Rose Furey, Notary Public

My Commission Expires February 13, 1960.

