


STATE OF KANSAS
STATE CORPORATION COMMISSION

WELL PLUGGING RECORD

Give All Information Completely
Make Required Affidavit
Mail or Deliver Report to
Conservation Division
State Corporation Comm.
245 North Water
Wichita, KS 67202

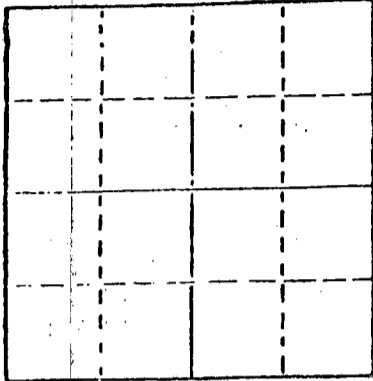

Locate well correctly on above
Section Plat

Rocks _____ County. Sec. 31 Twp. 9 Rge. 20 E/W
Location as "NE/CNW/SW" or footage from lines _____
NE SW SE
Lease Owner Bankoff Oil Co.
Lease Name Renner Well No. 1
Office Address P.O. Drawer 2479 Tulsa, Okla 74101
Character of Well (Completed as Oil, Gas or Dry Hole) _____
Dry Hole
Date Well completed August 20 19 77
Application for plugging filed Aug. 20 19 77
Application for plugging approved Aug. 20 19 77
Plugging commenced August 20 19 77
Plugging completed August 20 19 77
Reason for abandonment of well or producing formation _____

If a producing well is abandoned, date of last production _____
19 _____

Was permission obtained from the Conservation Division or
its agents before plugging was commenced? yes

Name of Conservation Agent who supervised plugging of this well Leo Massey
Producing formation _____ Depth to top _____ Bottom _____ Total Depth of Well 3900'
Show depth and thickness of all water, oil and gas formations.

OIL, GAS OR WATER RECORDS

CASING RECORD

FORMATION	CONTENT	FROM	TO	SIZE	PUT IN	PULLED OUT

Describe in detail the manner in which the well was plugged, indicating where the mud fluid
was placed and the method or methods used in introducing it into the hold. If cement or other
plugs were used, state the character of same and depth placed, from _____ feet to
_____ feet for each plug set.

Hole full of heavy mud.
Bottom plug at 720' with 70 sacks 50/50 pozmix, 6% Gel thru drill pipe
Heavy mud to 185', Plug with 20 sacks cement thru drill pipe.
Mud to 40', 1/2 sack hulls, plug and 10 sacks cement.

RECEIVED
STATE CORPORATION COMMISSION

AUG 25 1977
08-25-1977
CONSERVATION DIVISION
Wichita, Kansas

(If additional description is necessary, use BACK of this sheet)

Name of Plugging Contractor Duke Drilling Co. - Box 823 - Great Bend, Ks 67530

STATE OF Kansas COUNTY OF Barton, ss.
Larry Curtis (employee of owner) or (owner or operator)

of the above-described well, being first duly sworn on oath, says: That I have knowledge of
the facts, statements, and matters herein contained and the log of the above-described well
as filed and that the same are true and correct. So help me God.

(Signature) Larry Curtis
Box 823 - Great Bend, Ks. 67530
(Address)

SUBSCRIBED AND SWORN TO before me this 23 day of August, 19 77

Dorothy M. Sague
Notary Public.

My commission expires April 11, 1978



15-163-20725-00-00
Drillers' Well Log

Date Commenced: August 15 - 1977

Date Completed: August 20, 1977

Bankoff Oil Co.

Renner #1

NE SW SE

Section 31, T9N-R20W

Rooks County, Kansas

Elevation: 2279 K.B.

- 0 - 1771' Surface Soil - Shale
- 1771 - 1812' Anhydrite
- 1812 - 1850' Red Bed
- 1850 - 2603' Shale & Lime
- 2603 - 3536' Lime & Shale
- 3536 - 3540' Shale
- 3540 - 3577' Lime & Shale
- 3577 - 3800' Lime
- 3800 - 3900' Lime, Shale
- 3900' RJD

Formation Data

Anhydrite	1771
Heebner	3536
Toronto	3558
Lansing	3577
Base of K.C.	3800
RJD	3900

Surface Pipe: Set used
28# 8-5/8" pipe at 209' with
150 sacks common, 2% Gel, 3% cc.

Affidavit

State of Kansas

County of Barton) ss.

Larry Curtis of lawful age, does swear and state that the facts and statements herein contained are true and correct to the best of his knowledge.

Larry Curtis

Subscribed and sworn to before me this 23 day of August 1977.

My Comm. Expires:
April 11, 1978

Christy M. Hague
Notary Public

