


WELL PLUGGING RECORD

Give All Information Completely
Make Required Affidavit
Mail or Deliver Report to:
Conservation Division
State Corporation Commission
211 No. Broadway
Wichita, Kansas

NORTH

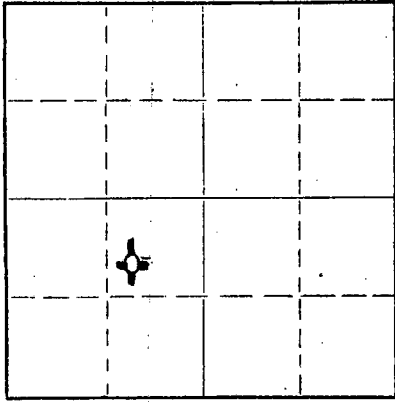

Locate well correctly on above
Section Plat

Rooks County. Sec. 34 Twp. 9 Rge. 20W (E) (W)
Location as "NE/CNW%SW%" or footage from lines SW NE SW
Lease Owner C-G Drilling Co. & Holly Oil Company
Lease Name Hinkhouse Well No. 1
Office Address 107 Rule Building, Wichita, Kansas
Character of Well (completed as Oil, Gas or Dry Hole) Dry Hole
Date well completed May 8 19 58
Application for plugging filed May 8 19 58
Application for plugging approved May 8 19 58
Plugging commenced May 8 19 58
Plugging completed May 8 19 58
Reason for abandonment of well or producing formation Too low structurally

If a producing well is abandoned, date of last production _____ 19____
Was permission obtained from the Conservation Division or its agents before plugging was commenced? Yes

Name of Conservation Agent who supervised plugging of this well Eldon Petty, Hays, Kansas
Producing formation _____ Depth to top _____ Bottom _____ Total Depth of Well 3870 Feet
Show depth and thickness of all water, oil and gas formations.

OIL, GAS OR WATER RECORDS

CASING RECORD

FORMATION	CONTENT	FROM	TO	SIZE	PUT IN	PULLED OUT
				8-5/8"	180.33'	none

Describe in detail the manner in which the well was plugged, indicating where the mud fluid was placed and the method or methods used in introducing it into the hole. If cement or other plugs were used, state the character of same and depth placed, from _____ feet to _____ feet for each plug set.

Filled hole with heavy mud to 550'. Set plug. Put in 25 sacks cement and 1/2 sack hulls. Filled to 155'. Set plug. Put in 15 sacks cement and 1/2 sack hulls. Filled with heavy mud up to 40'. Set plug. Filled to top with 10 sacks cement and 1/2 sack hulls.

RECEIVED
STATE CORPORATION COMMISSION

MAY 14 1958
05-14-1958
CONSERVATION DIVISION
Wichita, Kansas

(If additional description is necessary, use BACK of this sheet)
Name of Plugging Contractor C-G Drilling Co.
Address 107 Rule Building, Wichita, Kansas

STATE OF KANSAS, COUNTY OF SEDGWICK, ss.
G. F. Galloway (employee of owner) or (owner or operator) of the above-described well, being first duly sworn on oath, says: That I have knowledge of the facts, statements, and matters herein contained and the log of the above-described well as filed and that the same are true and correct. So help me God.

(Signature) G. F. Galloway
107 Rule Building
(Address)

Subscribed and Sworn to before me this 13th day of May, 1958
My commission expires May 20, 1959
Vicky Jacobs
Notary Public.



PLUGGING
FILE SEC. 34 T. 9 R. 20W
BOOK PAGE 100 LINE 5

15-163-00753-00-00

CONTRACTOR'S WELL LOG

OPERATOR C-G Drilling Co. & Holly Oil Co. WELL NAME Hinkhouse #1
LOCATION SW NE SW SEC. 34-9-20 RIG NO. 2
COUNTY Rooks STATE Kansas
COMMENCEMENT DATE April 30, 1958 COMPLETION DATE May 8, 1958

LOG OF WELL

Elevation 2255' kelly bushing.
All measurements taken from the top of kelly bushing.

Table with columns: FROM, TO, FORMATION, DEVIATION FROM VERTICAL, REMARKS. Rows include geological data such as Sand-Shale, Red Bed, Anhydrite, Shale-Shell, Shale-Lime, and Lime-Shale with depth measurements and deviation notes.

RECEIVED
STATE CORPORATION COMMISSION
MAY 14 1958
05-14-1953
CONSERVATION DIVISION
Wichita, Kansas

CASING LEFT IN HOLE AFTER COMPLETION

Ran 180.33' (9 jts.) 8-5/8" OD Surface Casing.

STATE OF KANSAS }
COUNTY OF SEDGWICK } SS.

The undersigned hereby certifies that to the best of his knowledge and belief, the above facts are true and correct.

C-G DRILLING CO.

By [Signature]

SUBSCRIBED AND SWORN TO BEFORE ME THIS 13th day of May, 1958.

[Signature]
Vicky Jacobs, Notary Public

My commission expires: May 20, 1959



PLUGGING
FILE SEC. 34 T. 9 R. 20W
BOOK PAGE 100 LINE 5