


Give All Information Completely
Make Required Affidavit
Mail or Deliver Report to:
Conservation Division
State Corporation Commission
211 No. Broadway
Wichita, Kansas

WELL PLUGGING RECORD

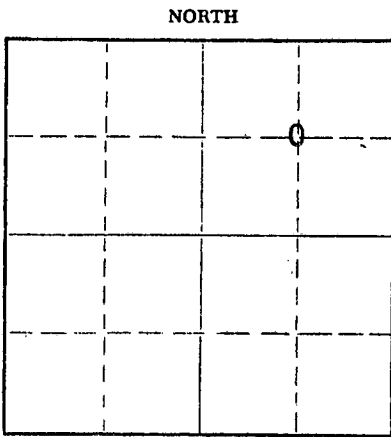

Locate well correctly on above
Section Plat

ROOKS County. Sec. 34 Twp. 9 Rge. 20 (E) W (W)
Location as "NE/CNW/SW" or footage from lines CENTER NE 1/4
Lease Owner DANE G HANSEN ESTATE
Lease Name CODDINGTON #10 Well No. _____
Office Address LOGAN, KANSAS
Character of Well (completed as Oil, Gas or Dry Hole) DRY HOLE
Date well completed NOV 6, 1967 19____
Application for plugging filed NOV 6, 1967 19____
Application for plugging approved NOV 6, 1967 19____
Plugging commenced NOV 6, 1967 19____
Plugging completed NOV 6, 1967 19____
Reason for abandonment of well or producing formation TOO LOW STRUCTURALLY

If a producing well is abandoned, date of last production _____ 19____
Was permission obtained from the Conservation Division or its agents before plugging was commenced? YES

Name of Conservation Agent who supervised plugging of this well LEO F MASSEY, HAYS, KANSAS
Producing formation _____ Depth to top _____ Bottom _____ Total Depth of Well 3866 Feet
Show depth and thickness of all water, oil and gas formations.

OIL, GAS OR WATER RECORDS

CASING RECORD

FORMATION	CONTENT	FROM	TO	SIZE	PUT IN	PULLED OUT
				8-5/8"	176.82'	NONE

Describe in detail the manner in which the well was plugged, indicating where the mud fluid was placed and the method or methods used in introducing it into the hole. If cement or other plugs were used, state the character of same and depth placed, from _____ feet to _____ feet for each plug set.

FILLED WITH HEAVY MUD TO 970'. SET PLUG. PUT IN 70 SACKS CEMENT, AND gel. FILLED WITH HEAVY MUD TO 205' SET PLUG. PUT IN 12 SACKS CEMENT, AND GEL. FILLED WITH HEAVY MUD TO 40'. SET PLUG. FILLED TO TOP WITH 8 SACKS CEMENT AND GEL.

RECEIVED
STATE CORPORATION COMMISSION
NOV 17 1967
11-17-1967
CONSERVATION DIVISION
Wichita, Kansas

(If additional description is necessary, use BACK of this sheet)
Name of Plugging Contractor C-G DRILLING CO.
Address 107 RULE BUILDING, WICHITA, KANSAS 67202


STATE OF KANSAS, COUNTY OF SEDGWICK, ss.
G F GALLOWAY (employee of owner) or (~~owner or operator~~) of the above-described well, being first duly sworn on oath, says: That I have knowledge of the facts, statements, and matters herein contained and the log of the above-described well as filed and that the same are true and correct. So help me God.

(Signature) G F GALLOWAY
107 RULE BUILDING
(Address)

Subscribed and sworn to before me this 10th day of NOVEMBER, 1967

My commission expires JAN. 23, 1968

Phyllis McJimsey
PHYLLIS McJIMSEY Notary Public.

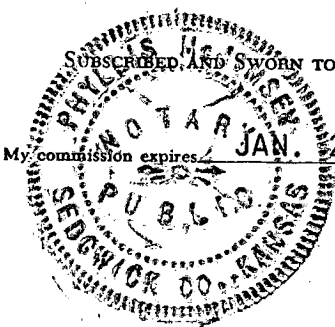

15-163-20074-00-00

WELL LOG

OPERATOR: DANE G HANSEN ESTATE

WELL NAME: GODDINGTON #10 LOCATION: CENTER NE 1/4 SEC 34-9-20W

COUNTY: ROOKS STATE: KANSAS

WELL COMMENCED: 10/30/67 WELL COMPLETED: 11/6/67

ELEVATION: 2283 KB TOTAL DEPTH: 3866'

PRODUCTION: DRY & ABANDONED RIG NO: 1

CASING - 8-5/8": 176.82' (9 jts) W/150 SACKS QUICKSET

5-1/2": _____

All Measurements taken from the top of rotary bushing.

FROM	TO	FORMATION	DEVIATION FROM VERTICAL	REMARKS:
190	1255	SHALE	1-3/4°	1650'
1255	1330	SAND	1-1/2°	2040'
1330	1525	SHALE & SAND	1°	2500
1525	1771	SHALE	1/2°	2945'
1771	1809	ANHYDRITE		
1809	2200	RED BED & SHALE		
2200	2230	SHALE		
2230	3645	LIME & SHALE		
3645	3785	LIME		
3785	3826	LIME & SHALE		
3826	3861	LIME & CHERT & SHALE		
3861	3866	ARBUCKLE		

RECEIVED
 STATE CORPORATION COMMISSION
 NOV 17 1967
 CONSERVATION DIVISION
 Wichita, Kansas

STATE OF KANSAS)
 COUNTY OF SEDGWICK) SS:

The undersigned hereby certifies that to the best of his knowledge and belief, the above facts are true and correct.

C-G DRILLING CO.

By G F Galloway
 G F GALLOWAY

Subscribed and sworn to, before me, this 10th day of NOV., 1967.



Phyllis McJimsey
 Phyllis McJimsey ---Notary Public