


15-065-02331-06-00

WELL PLUGGING RECORD

Give All Information Completely  
Make Required Affidavit  
Mail or Deliver Report to:  
Conservation Division  
State Corporation Commission  
211 No. Broadway  
Wichita, Kansas

Graham County, Sec. 5 Twp. 9 Rge. (E) 21 (W)

NORTH

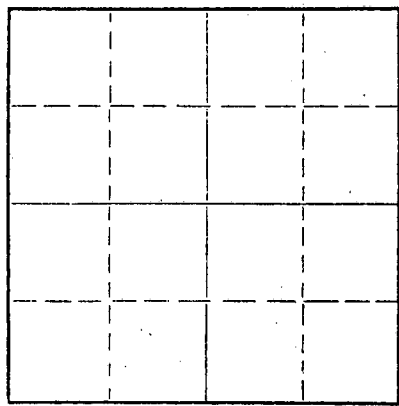

Locate well correctly on above Section Plat

Location as "NE/CNW%SW%" or footage from lines NW SW NW  
Lease Owner Jones, Shelburne & Farmer, Inc.  
Lease Name Hatcher "B" Well No. 1  
Office Address Russell, Kansas  
Character of Well (completed as Oil, Gas or Dry Hole) dry  
Date well completed 9-12 19 56  
Application for plugging filed 9-12 19 56  
Application for plugging approved 9-12 19 56  
Plugging commenced 9-12 19 56  
Plugging completed 9-12 / 19 56  
Reason for abandonment of well or producing formation dry

If a producing well is abandoned, date of last production \_\_\_\_\_ 19\_\_\_\_  
Was permission obtained from the Conservation Division or its agents before plugging was commenced? yes

Name of Conservation Agent who supervised plugging of this well Eldon Petty  
Producing formation \_\_\_\_\_ Depth to top \_\_\_\_\_ Bottom \_\_\_\_\_ Total Depth of Well 3837 Feet  
Show depth and thickness of all water, oil and gas formations.

OIL, GAS OR WATER RECORDS

CASING RECORD

FORMATION	CONTENT	FROM	TO	SIZE	PUT IN	PULLED OUT
				8 5/8	162	None

Describe in detail the manner in which the well was plugged, indicating where the mud fluid was placed and the method or methods used in introducing it into the hole. If cement or other plugs were used, state the character of same and depth placed, from \_\_\_\_\_ feet to \_\_\_\_\_ feet for each plug set.

1. Filled hole with heavy mud
2. Pushed plug to 157
3. Dumped 1/2 sack hulls on top of plug
4. Mixed 15 sacks cement and dumped on top of hulls.
5. Filled hole to top
6. Pushed plug to 40
7. Dumped in 1/2 sack hulls
8. Mixed 10 sacks cement and filled hole to top with same.

SEP 17 1956  
COMMISSION

(If additional description is necessary, use BACK of this sheet)


Name of Plugging Contractor Jones, Shelburne & Farmer, Inc.  
Address Russell, Kansas

9-18-56

STATE OF Kansas, COUNTY OF Russell, ss.  
John O. Farmer (employee of owner) or (owner or operator) of the above-described well, being first duly sworn on oath, says: That I have knowledge of the facts, statements, and matters herein contained and the log of the above-described well as filed and that the same are true and correct. So help me God.

(Signature) John O. Farmer  
Russell, Kansas  
(Address)

SUBSCRIBED AND SWORN to before me this 18th day of September, 19 56  
My commission expires Oct. 11, 1958  
Notary Public.

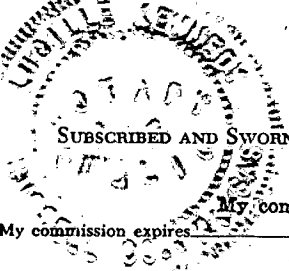

PLUGGING  
FILE SEC 5 T. 9 R. 21W  
BOOK PAGE 98 LINE 36

