


STATE OF KANSAS
STATE CORPORATION COMMISSION

Give All Information Completely
Make Required Affidavit
Mail or Deliver Report to:
Conservation Division
State Corporation Commission
800 Bittling Building
Wichita, Kansas

15-065-02445-00-00

WELL PLUGGING RECORD

NORTH

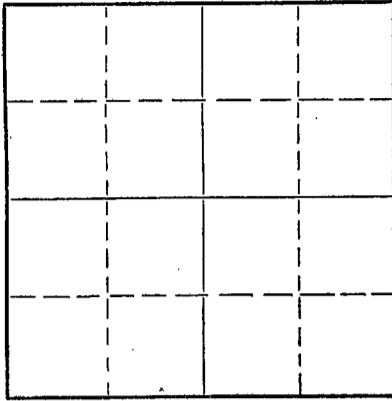

Locate well correctly on above
Section Plat

Graham County, Sec. 9 Twp. 9S Rge. 21 (W)
Location as "NE/CNW%SW%" or footage from lines SW/4 NW/4 SE/4
Lease Owner Barnett Oil Company
Lease Name Drumm Well No. 1
Office Address First National Bank Bldg., Wichita, Kansas
Character of Well (completed as Oil, Gas or Dry Hole) Dry Hole
Date well completed April 16, 1955
Application for plugging filed April 18, 1955
Application for plugging approved April 19, 1955
Plugging commenced April 16, 1955
Plugging completed April 16, 1955
Reason for abandonment of well or producing formation Dry Hole

If a producing well is abandoned, date of last production - - 19
Was permission obtained from the Conservation Division or its agents before plugging was commenced? Yes

Name of Conservation Agent who supervised plugging of this well Eldon Petty
Producing formation None Depth to top Bottom Total Depth of Well 3776 Feet
Show depth and thickness of all water, oil and gas formations.

OIL, GAS OR WATER RECORDS

CASING RECORD

FORMATION	CONTENT	FROM	TO	SIZE	PUT IN	PULLED OUT
Surface Casing				8 5/8"	140'	None

Describe in detail the manner in which the well was plugged, indicating where the mud fluid was placed and the method or methods used in introducing it into the hole. If cement or other plugs were used, state the character of same and depth placed, from feet to feet for each plug set.

Filled hole with mud to 145 ft. Dumped 1/2 sack of hulls. Pushed plug to 145 ft., and dumped 15 sacks of cement. Filled hole with mud to 40 ft. Dumped 1/2 sack of hulls and set plug at 40 ft. Filled casing to bottom of cellar with 10 sacks of cement.

Well log attached.

(If additional description is necessary, use BACK of this sheet)

Name of Plugging Contractor Barnett Drilling, Inc.
Address First National Bank Building, Wichita, Kansas

STATE OF Kansas, COUNTY OF Sedgwick, ss.
F. H. Rousey (employee of owner) or owner or operator of the above-described well, being first duly sworn on oath, says: That I have knowledge of the facts, statements, and matters herein contained and the log of the above-described well as filed and that the same are true and correct. So help me God.

(Signature) F. H. Rousey
First Nat'l Bank Bldg., Wichita, Kansas
(Address)

SUBSCRIBED AND SWORN TO before me this 20th day of April, 1955.

My commission expires February 27, 1956.



Mildred J. Willis
Notary Public.

PLUGGING
FILE SEC 9 T 9 R 21 W
BOOK PAGE 112 LINE 26

RECEIVED
CORPORATION COMMISSION
APR 21 1955 4-21-55
CONSERVATION DIVISION
Wichita, Kansas

15-065-02445-00-00


BARNETT OIL COMPANY
LOG OF DRUMM WELL NO. 1
SW/4 NW/4 SE/4 SECTION 23-17S-25W
GRAHAM COUNTY, KANSAS

DATE COMMENCED: April 4, 1955

DATE COMPLETED: April 16, 1955

<u>Formation</u>	<u>From</u>	<u>To</u>
Surface	0	30
Sand	30	45
Shale	45	85
Sand	85	90
Shale	90	141
Shale and Shells	141	680
Shale	680	1150
Sand	1150	1400
Shale	1400	1675
Anhydrite	1675	1710
Shale and Shells	1710	1960
Shale	1960	2140
Shale and Shells	2140	2400
Shale and Lime	2400	2505
Lime	2505	2615
Lime and Shale	2615	2745
Lime	2745	2910
Lime and Shale	2910	3360
Lime	3360	3705
Lime and Shale	3705	3727
Lime	2727	3776 (Total Depth)

Set 8 5/8" O.D. 8rd. thd. 24# surface-casing at 140' R.B.,
on April 6, 1955, and cemented with 125 sacks of Portland Cement.

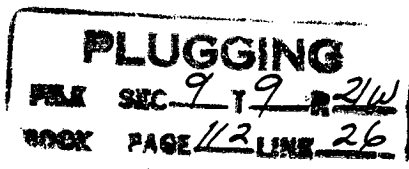

42155
RECEIVED
STATE CORPORATION COMMISSION

APR 21 1955

CONSERVATION DIVISION
Wichita, Kansas