


15-163-20535-00-00

STATE OF KANSAS  
STATE CORPORATION COMMISSION  
CONSERVATION DIVISION  
P. O. BOX 17027  
WICHITA, KANSAS 67217

FORM CP-4

WELL PLUGGING RECORD

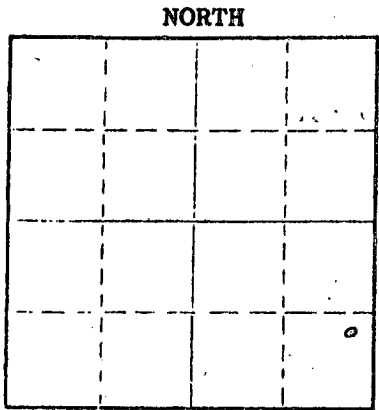

Locate well correctly on above Section Plot

Rooks County, Sec. 21 Twp. 8 Rge. 18 (E) (XX)  
Location as "NE/CNW/SW" or footage from lines NE SE SE  
Lease Owner Cities Service Oil Company  
Lease Name Mosher Well No. 5  
Office Address 209 E. William, 700 Sutton Pl. Bldg. Wichita, KS  
Character of Well (completed as Oil, Gas or Dry Hole) Dry Hole  
Date well completed 7-13 1974  
Application for plugging filed 7-15 1974  
Application for plugging approved 7-16 1974  
Plugging commenced 7-13 1974  
Plugging completed 7-13 1974  
Reason for abandonment of well or producing formation Dry Hole

If a producing well is abandoned, date of last production 19  
Was permission obtained from the Conservation Division or its agents before plugging was commenced? Yes - Verbal

Name of Conservation Agent who supervised plugging of this well Leo Massey  
Producing formation \_\_\_\_\_ Depth to top \_\_\_\_\_ Bottom \_\_\_\_\_ Total Depth of Well 3465 Feet  
Show depth and thickness of all water, oil and gas formations.

OIL, GAS OR WATER RECORDS

CASING RECORD

| FORMATION | CONTENT | FROM | TO | SIZE   | PUT IN | PULLED OUT |
|-----------|---------|------|----|--------|--------|------------|
|           |         |      |    | 8 5/8" | 209'   | - 0 -      |
|           |         |      |    |        |        |            |
|           |         |      |    |        |        |            |
Describe in detail the manner in which the well was plugged, indicating where the mud fluid was placed and the method or methods used in introducing it into the hole. If cement or other plugs were used, state the character of same and depth placed, from \_\_\_\_\_ feet to \_\_\_\_\_ feet for each plug set.

Ran Welex radiation guard log with caliper. Plugged: Spot 70 sacks 50/50 pozmix with 6% Gel at 675'. Spot 20 sacks 50/50 pozmix with 6% Gel at 245'. Bridged at 40' with 1 sack hulls and top cementing plug. Filled 40' to surface with 10 sacks 50/50 pozmix with 6% Gel. Complete at 7:30 P.M. 7/13/74.

RECEIVED  
STATE CORPORATION COMMISSION  
JUL 18 1974  
CONSERVATION DIVISION  
Wichita, Kansas  
17-18-74

Name of Plugging Contractor Red Tiger Drilling Co. (If additional description is necessary, use BACK of this sheet)  
Address 1720 Wichita Plaza, Wichita, Kansas 67202

STATE OF Kansas COUNTY OF Sedgwick ss.  
E. W. Peterman (employee of owner) or (owner or operator) of the above-described

well, being first duly sworn on oath, says: That I have knowledge of the facts, statements, and matters herein contained and the log of the above-described well as filed and that the same are true and correct. So help me God.

(Signature) E. W. Peterman

209 E. William, 700 Sutton Pl. Bldg. - Wichita, KS  
(Address) 67202

Subscribed and sworn to before me this 17th day of July 19 74

My commission expires 10-16-77 DEAN CALDWELL Notary Public.

