


STATE OF KANSAS
STATE CORPORATION COMMISSION

WELL PLUGGING RECORD

Give All Information Completely
Make Required Affidavit
Mail or Deliver Report to
Conservation Division
State Corporation Comm.
245 North Water
Wichita, KS 67202

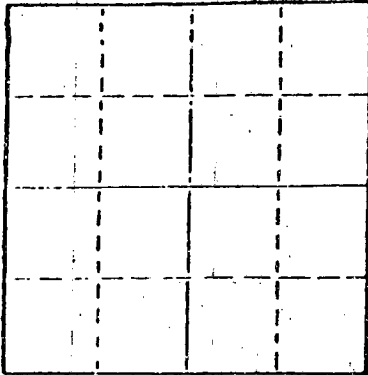

Locate well correctly on above
Section Plat

Rooks County. Sec. 24 Twp. 8s Rge. 18w E/W
Location as "NE/CNW1SW1" or footage from lines
1110' FNL 390" FWL

Lease Owner Eric Waddell Company

Lease Name Collins Well No. 2

Office Address Box 349 Natoma, Kansas 67651

Character of Well (Completed as Oil, Gas or Dry Hole)

dry hole

Date Well completed 11-6-82 19

Application for plugging filed 11-6-82 19

Application for plugging approved 11-6-82 19

Plugging commenced 1:45 P.M. 11-6-82 19

Plugging completed 6:00 P.M. 11-6-82 19

Reason for abandonment of well or producing formation

dry

If a producing well is abandoned, date of last production

19

Was permission obtained from the Conservation Division or
its agents before plugging was commenced? yes

Name of Conservation Agent who supervised plugging of this well Carl Goodrow

Producing formation _____ Depth to top _____ Bottom _____ Total Depth of Well _____

Show depth and thickness of all water, oil and gas formations.

OIL, GAS OR WATER RECORDS

CASING RECORD

FORMATION	CONTENT	FROM	TO	SIZE	PUT IN	PULLED OUT

Describe in detail the manner in which the well was plugged, indicating where the mud fluid was placed and the method or methods used in introducing it into the hold. If cement or other plugs were used, state the character of same and depth placed, from _____ feet to _____ feet for each plug set.

1st plug at 3451 with 20 sacks
 2nd plug at 1348 with 20 sacks
 3rd plug at 750 with 80 sacks
 4th plug at 225 with 40 sacks
 5th plug at 40 with 10 sacks with 1 sack hulls for solid bridge
 10 sacks for rat hole Total 180 sacks 50/50 poz 6% gel
 3% cc

(If additional description is necessary, use BACK of this sheet)

Name of Plugging Contractor Lawbanco Drilling, Inc.
Box 289 Natoma, Kansas 67651

STATE OF Kansas COUNTY OF Osborne, ss.
R. L. Finnesy (employee of owner) or (owner or operator)

of the above-described well, being first duly sworn on oath, says: That I have knowledge of the facts, statements, and matters herein contained and the log of the above-described well as filed and that the same are true and correct. So help me God.


(Signature) R. L. Finnesy

2220 Marjorie Hays, Kansas 67601
(Address)

SUBSCRIBED AND SWORN TO before me this 9th day of November, 1982

My commission expires

4-20-85

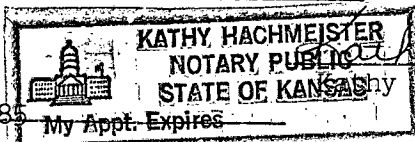

Kathy Hachmeister
Notary Public.

RECEIVED
STATE CORPORATION COMMISSION

NOV 10 1982
NOV 10 1982
CONSERVATION DIVISION
Wichita, Kansas