


Give All Information Completely
Make Required Affidavit
Mail or Deliver Report to:
Conservation Division
State Corporation Commission
800 Bitting Building
Wichita, Kansas

OR
FORMATION PLUGGING RECORD

Strike out upper line
when reporting plug-
ging off formations.

NORTH

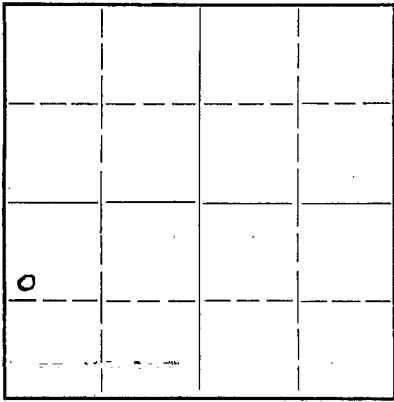

Locate well correctly on above
Section Plat

Rooks County, Sec. 27, Twp. 8S, Rge. 18W (E) (W)
Location as "NE 1/4 NW 1/4 SW 1/4" or footage from lines SW 1/4 NW 1/4 SW 1/4
Lease Owner Continental Oil Co.
Lease Name Fleming Well No. 1
Office Address Ponca City, Okla.
Character of Well (completed as Oil, Gas or Dry Hole) Stratigraphic Test
Date well completed Aug. 12, 1942 19
Application for plugging filed Aug. 12, 1942 19
Application for plugging approved Aug 13, 1942 19
Plugging commenced Aug. 12, 1942 19
Plugging completed Aug. 13, 1942 19
Reason for abandonment of well or producing formation
If a producing well is abandoned, date of last production 19
Was permission obtained from the Conservation Division or its agents before plugging was com-
menced? Yes

Name of Conservation Agent who supervised plugging of this well C. T. Alexander
Producing formation Depth to top Bottom Total Depth of Well Feet
Show depth and thickness of all water, oil and gas formations.



OIL, GAS OR WATER RECORDS

CASING RECORD

Formation	Content	From	To	Size	Put In	Pulled Out
				8 5/8	105 ft.	0

Describe in detail the manner in which the well was plugged, indicating where the mud fluid was placed and the method or methods used in introducing it into the hold. If cement or other plugs were used, state the character of same and depth placed, from feet to feet for each plug set.

The hole was filled with heavy mud and circulated every 500 ft. from the bottom up to the bottom of the surface pipe at 105 ft. The hole was bridged there with wood plug, rock and burlap and 10 sacks of cement placed on top of it thru the drill pipe. The hole was filled with mud to 26 ft. where it was bridged with a wood plug, rock and burlap and cemented to the top.

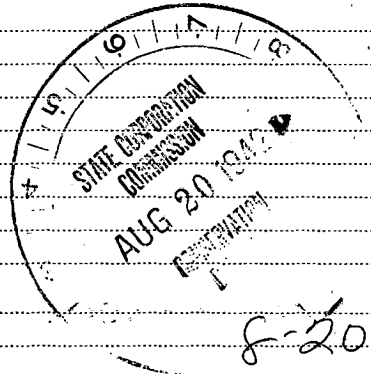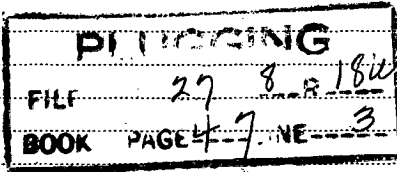

(If additional description is necessary, use BACK of this sheet)

Correspondence regarding this well should be addressed to J. George Klein
Address Plainville, Kansas

8-20-42

STATE OF Kansas, COUNTY OF Rooks, ss.
J. George Klein (employee of owner) or (owner or operator) of the above-described well, being first duly sworn on oath, says: That I have knowledge of the facts, statements, and matters herein contained and the log of the above-described well as filed and that the same are true and correct. So help me God.

(Signature) J. George Klein
Plainville, Kansas (Address)

Subscribed and sworn to before me this 19 day of August, 1942
Notary Public

