


15-163-02682-0000

WELL PLUGGING RECORD

Give All Information Completely
Make Required Affidavit
Mail or Deliver Report to:
Conservation Division
State Corporation Commission
800 Bittling Building
Wichita, Kansas

Rooks County, Sec. 28 Twp. 8 Rge. 18W (E) (W)
Location as "NE/CNW 1/4 SW 1/4" or footage from lines CN 1/2 NE SE
Lease Owner C. W. Trickett et al
Lease Name Kennedy Well No. 1
Office Address Bird City, Kansas
Character of Well (completed as Oil, Gas or Dry Hole) Dry Hole
Date well completed November 12, 1945
Application for plugging filed April 10, (verbal) 1949
Application for plugging approved April 15, 1949
Plugging commenced April 10, 1949
Plugging completed April 15, 1949
Reason for abandonment of well or producing formation Dry Hole

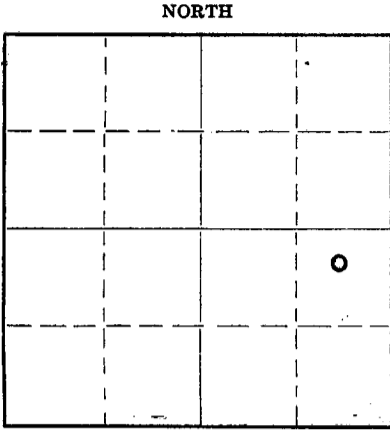

Locate well correctly on above Section Plat

If a producing well is abandoned, date of last production none 19
Was permission obtained from the Conservation Division or its agents before plugging was commenced? Yes

Name of Conservation Agent who supervised plugging of this well C. D. Stough & Eldon Petty
Producing formation Depth to top Bottom Total Depth of Well 3325 Feet
Show depth and thickness of all water, oil and gas formations.

OIL, GAS OR WATER RECORDS

CASING RECORD

Formation	Content	From	To	Size	Put In	Pulled Out
				10 3/4	80'	none
				5 1/2"	3164'	not available

Describe in detail the manner in which the well was plugged, indicating where the mud fluid was placed and the method or methods used in introducing it into the hole. If cement or other plugs were used, state the character of same and depth placed, from feet to feet for each plug set.

10 inch casing set at 80 feet, circulated with cement. 5 1/2 inch at 3164 feet. Sand to 3100 feet and 5 sacks cement to 3045 feet. Heavy mud to 208 feet and wood plug, rock and 20 sacks cement. Heavy mud to 30 feet, wood plug, rock and 10 sacks cement. 5 1/2 inch shot and pulled at 2720 feet.

RECORDED

SEP 10 1949

ST. COMM. DIVISION KANSAS

(If additional description is necessary, use BACK of this sheet)
Correspondence regarding this well should be addressed to C. W. Trickett, Bird City, Kansas
Address 9-10-49


STATE OF Kansas, COUNTY OF Rooks, ss.
C. W. Trickett (employee of owner) or (owner or operator) of the above-described well,
being first duly sworn on oath, says: That I have knowledge of the facts, statements, and matters herein contained and the log of the above-described well as filed, and that the same are true and correct. So help me God.

(Signature) C. W. Trickett

(Address)


A. L. Benbholder

Notary Public.

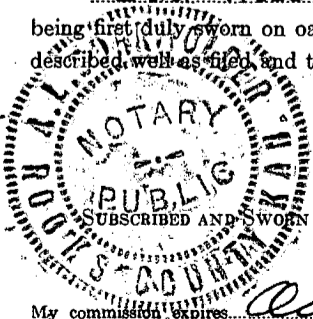

SUBSCRIBED AND SWORN to before me this 9 day of September, 1949

My commission expires Oct 30 1950

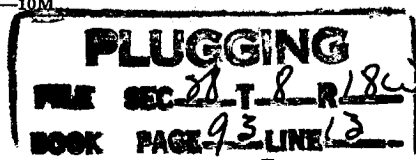

15-163-02682-00-00

STERLING DRILLING COMPANY

STERLING, KANSAS

WELL LOG ----- KENNEDY NO. 1

Location - CS/2 NE SE of Section 28-8S-18W, Rooks County, Kansas.

Owner - - - C. W. Trickett, et al, Bird City, Kansas.
Contractor - Sterling Drilling Company, Sterling, Kansas

Commenced - 11-1-45
Completed - 11-12-45 (w/r)

LOG

0- 30	Shale
30- 40	Rock
40- 300	Shale
300- 585	Shale and Shells
585- 635	Anhydrite
635- 850	Shale
850-1050	Sand
1050-1670	Shale and Shells
1670-1790	Lime and Shale
1790-1940	Broken Lime
1940-2045	Shale and Shells
2045-2245	Lime
2245-2330	Shale and Shells
2330-2780	Lime and Shale*
2780-2930	Shale and Shells
2930-2970	Lime
2970-3130	Shale and Lime
3130-3144	Lime

CASING RECORD

80 Feet 10-3/4" Surface Casing
Cemented with 45 Sacks Cement

3144 Feet 5 1/2-inch Production Casing
Cemented with 75 Sacks Cement

Total Depth - 3144' (w/r)

PLUGGING
FILE SEC RT R 12
BOOK PAGE 93 LINE 3

RECEIVED

Conservation Div.
AUG 20 1949
STATE CORPORATION
COMMISSION
KANSAS

8-20-49

15-163-62682-00-00


WELL LOG BUREAU - KANSAS GEOLOGICAL SOCIETY
412 Union National Bk. Bldg., Wichita, Kansas

Company - C. W. TRICKETT, ET AL
Farm - Kennedy No. 1

SEC. 28 T. 8 R. 18W
CN $\frac{1}{2}$ NE SE

Total Depth. 3325'
Comm. 11-1-45 Comp. 11-12-45
Shot or Treated.
Cont. Cor. Sterling Drlg. Co.
Issued 6-7-47

County. Rooks
KANSAS

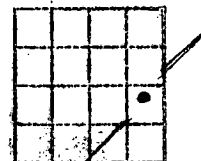

CASING:
10 $\frac{3}{4}$ " 80' cem. w/45 sx.
5 $\frac{1}{2}$ " 3144' cem. w/75 sx.

Elevation. _____

Production. Dry

Figures Indicate Bottom of Formations.

shale	0-30
rock	40
shale	300
shale & shells	535
anhydrite	635
shale	850
sand	1050
shale & shells	1670
lime & shale	1790
lime brkn	1940
shale & shells	2045
lime	2245
shale & shells	2330
lime & shale	2780
shale & shells	2930
lime	2970
shale & lime	3130
lime	3144
No Log	3325
Total Depth	

The Bureau could not
secure Cable tool Log from
3144 to 3325 TD.

RECEIVED

CC

AUG 19 1949

STATE CORPORATION
COMMISSION
KANSAS

8-19-49