

CARD MUST BE TYPED

State of Kansas

CARD MUST BE SIGNED

NOTICE OF INTENTION TO DRILL

(see rules on reverse side)

✓
6

Expected Spud Date..... 10/17/80
month day year

API Number 15-125-29,102-00-00

OPERATOR: License # 4469

SE NE NE Sec...13 Twp...34 S, Rg...13. XX West

Name KELT ENERGY

4165 Ft. from South Line of Section

Address 900 COLLEGE DRIVE

330 Ft. from East Line of Section

City/State/Zip INDEPENDENCE 67301

(Note: Locate well on Section Plat on reverse side)

Contact Person FADI NAMMOUR

Nearest lease or unit boundary line 330 feet

Phone (316) 331-0207

County MONTGOMERY

CONTRACTOR: License # 9350

Lease Name SHEIK Well # KHHS-4

Name THOMPSON DRILLING CO., INC.

Ground surface elevation 880 feet MSL

City/State INDEPENDENCE 67301

Domestic well within 330 feet: yes XXno

Well Drilled For: Well Class: Type Equipment:

Municipal well within one mile: yes XXno

XX Oil XX Storage XX Infield XX Mud Rotary

Depth to bottom of fresh water 165

XX Gas XX Inj XX Pool Ext. XX Air Rotary

Depth to bottom of usable water 175

XX OWWO XX Expl XX Wildcat XX Cable

Surface pipe by Alternate: 1 XX 2

If OWWO: old well info as follows:

Surface pipe planned to be set 40

Operator

Conductor pipe required *****

Well Name

Projected Total Depth 1500 feet

Comp Date Old Total Depth

Formation MISSISSIPPI

I certify that well will comply with K.S.A. 55-101, et seq., plus eventually plugging hole to KCC specifications.

Date 10/17/88 Signature of Operator or Agent Title AS AGENT

For KCC Use:

Conductor Pipe Required feet; Minimum Surface Pipe Required 20' feet per Alt. X (2)

This Authorization Expires 4-17-89 Approved By LKM 10-17-88

EFFECTIVE DATE: 10-22-88


Must be filed with the K.C.C. five (5) days prior to commencing well
This card void if drilling not started within six (6) months of date received by K.C.C.

Important procedures to follow:

1. Notify District office before setting surface casing.
2. Set surface casing by circulating cement to the top.
3. File completion forms ACO-1 with K.C.C. within 120 days of well spud date, following instructions on ACO-1, side 1, and including copies of wireline logs.
4. Notify District office 48 hours prior to old well workover or re-entry.
5. Prior to filing Intent, prepare a proposed plugging plan in case well is D & A, then obtain approval of plan when calling district office prior to setting surface pipe.
6. Submit plugging report (CP-4) to K.C.C. after plugging is completed.
7. Obtain an approved injection docket number before disposing of salt water.
8. Notify K.C.C. within 10 days when injection commences or terminates.
9. If an alternate 2 completion, cement in the production pipe from below any usable water to surface within 120 days of spud date.

A Regular Section of Land

1 Mile = 5,280 Ft.

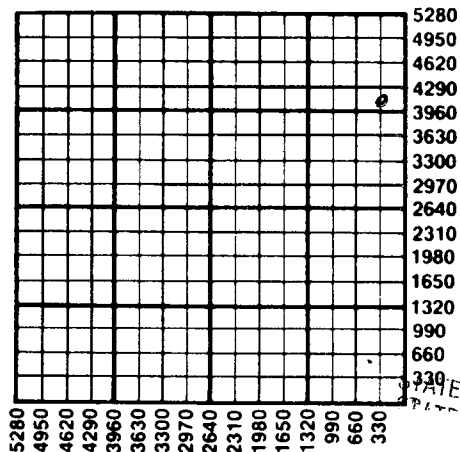

RECEIVED
STATE CORPORATION COMMISSION

OCT 17 1988

CONSERVATION DIVISION
Wichita, Kansas

10-17-88

State Corporation Commission of Kansas
Conservation Division
200 Colorado Derby Building
Wichita, Kansas 67202-1212
(316) 263-3238