

CARD MUST BE TYPED

State of Kansas

## NOTICE OF INTENTION TO DRILL

(see rules on reverse side)

CARD MUST BE SIGNED

No pits being dug per operatorExpected Spud Date. 02/17/88  
month day yearOPERATOR: License # 9313Name Jim LorenzAddress Rt #4City/State/Zip Parsons, Kansas 66720Contact Person Jim LorenzPhone (316) 421-6906CONTRACTOR: License # 5379Name Kenhardt DrillingCity/State Thayer, Kansas 66776

Well Drilled For: Well Class: Type Equipment:

Oil Storage ☒ Infield Mud Rotary☒ Gas Inj Pool Ext. ☒ Air RotaryOWWO Expl Wildcat Cable

If OWWO: old well info as follows:

Operator .....

Well Name .....

Comp Date ..... Old Total Depth .....

I certify that well will comply with K.S.A. 55-101, et seq., plus eventually plugging hole to KCC specifications.

Date 02/17/88 Signature of Operator or Agent Greg Engelman Title S. Agent

For KCC Use:

Conductor Pipe Required ..... feet; Minimum Surface Pipe Required ..... feet per Alt. 20 X 2This Authorization Expires 8-17-88 Approved By P. # 2-17-88EFFECTIVE DATE: 2-22-88API Number 15— 099-22,632-00-00NE NE NW Sec 17 Twp 32 S, Rg 19 ☒ East4785 Ft. from South Line of Section2970 Ft. from East Line of Section

(Note: Locate well on Section Plat on reverse side)

Nearest lease or unit boundary line 330 feetCounty LafayetteLease Name C. & J. Farms Well # 7

Ground surface elevation ..... feet MSL

Domestic well within 330 feet: yes ☒ noMunicipal well within one mile: yes ☒ no

Depth to bottom of fresh water .....

Depth to bottom of usable water 150Surface pipe by Alternate: 1 2 ☒Surface pipe planned to be set 20

Conductor pipe required .....


Projected Total Depth 850 feetFormation Mississippian

Must be filed with the K.C.C. five (5) days prior to commencing well  
This card void if drilling not started within six (6) months of date received by K.C.C.

### Important procedures to follow:

1. Notify District office before setting surface casing.
2. Set surface casing by circulating cement to the top.
3. File completion forms ACO-1 with K.C.C. within 120 days of well spud date, following instructions on ACO-1, side 1, and including copies of wireline logs.
4. Notify District office 48 hours prior to old well workover or re-entry.
5. Prior to filing Intent, prepare a proposed plugging plan in case well is D & A, then obtain approval of plan when calling district office prior to setting surface pipe.
6. Submit plugging report (CP-4) to K.C.C. after plugging is completed.
7. Obtain an approved injection docket number before disposing of salt water.
8. Notify K.C.C. within 10 days when injection commences or terminates.
9. If an alternate 2 completion, cement in the production pipe from below any usable water to surface within 120 days of spud date.

### A Regular Section of Land 1 Mile = 5,280 Ft.

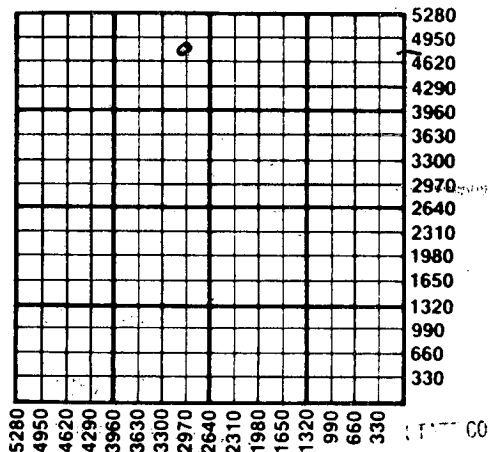

STATE CORPORATION COMMISSION

FEB 17 1988

CONSERVATION DIVISION  
Wichita, Kansas

2-17-88

State Corporation Commission of Kansas

Conservation Division  
200 Colorado Derby Building  
Wichita, Kansas 67202-1212  
(316) 263-3238