

NOTICE OF INTENTION TO DRILL

(see rules on reverse side)

Starting Date June 16 1986 month day year

API Number 15- 099-22,478-0000

OPERATOR: License # 5499/9313 Name Brecheisen Oil Co/James Lorenz Address Box 40 City/State/Zip Garnett, Kansas 66032 Contact Person A.W. Brecheisen Phone 913 448-6952

NW ..NW ..NW ..NW Sec. 33 Twp. 32 S, Rg. 18 East West 4950 Ft. from South Line of Section 4950 Ft. from East Line of Section

(Note: Locate well on Section Plat on reverse side)

CONTRACTOR: License # 5379 Name Kephart Drilling Inc. City/State Thayer, Kansas 66776

Nearest lease or unit boundary line 330 feet County Labette Lease Name David Meyers Well # 1 Ground surface elevation na feet MSL Domestic well within 330 feet: yes no Municipal well within one mile: yes no Depth to bottom of fresh water 20 Depth to bottom of usable water 150 Surface pipe by Alternate: 1 2 X Surface pipe planned to be set 20 Conductor pipe required na Projected Total Depth 1000 feet Formation

Well Drilled For: Well Class: Type Equipment: X Oil SWD X Infield X Mud Rotary Gas Inj Pool Ext Air Rotary OWWO Expl Wildcat Cable

If OWWO: old well info as follows:

Operator Well Name Comp Date Old Total Depth

I certify that well will comply with K.S.A. 55-101, et seq., plus eventually plugging hole to KCC specifications.

Date 6/16/86 Signature of Operator or Agent Title as agent

For KCC Use:

Conductor Pipe Required feet; Minimum Surface Pipe Required 20 feet per Alt. This Authorization Expires 12-16-86 Approved By 6-16-86


Handwritten signature and initials at bottom right.

Must be filed with the K.C.C. five (5) days prior to commencing well
This card void if drilling not started within six (6) months of date received by K.C.C.

Important procedures to follow:

1. Notify District office before setting surface casing.
2. Set surface casing by circulating cement to the top.
3. File completion forms ACO-1 with K.C.C. within 90 days of well completion, following instructions on ACO-1, side 1, and including copies of wireline logs.
4. Notify District office 48 hours prior to old well workover or re-entry.
5. Prior to filing Intent, prepare a proposed plugging plan in case well is D & A, then obtain approval of plan when calling district office prior to setting surface pipe.
6. Submit plugging report (CP-4) to K. C. C. after plugging is completed.
7. Obtain an approved injection docket number before disposing of salt water.
8. Notify K.C.C. within 10 days when injection commences or terminates.

A Regular Section of Land 1 Mile = 5,280 Ft.

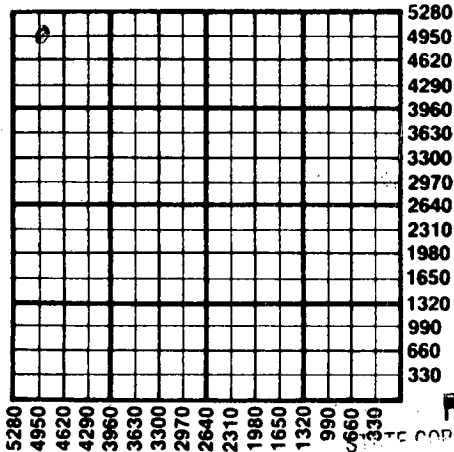

RECEIVED
JUN 16 1986
6-16-86
CONSERVATION DIVISION
Wichita, Kansas

an alternate 2 completion, cement in the production pipe from below any usable water to surface within 120 days of spud date.

State Corporation Commission of Kansas
Conservation Division
200 Colorado Derby Building
Wichita, Kansas 67202
(316) 263-3238